


STATE OF KANSAS
STATE CORPORATION COMMISSION

Give All Information Completely
Make Required Affidavit
Mail or Deliver Report to
Conservation Division
State Corporation Comm.
245 North Water
Wichita, KS 67202

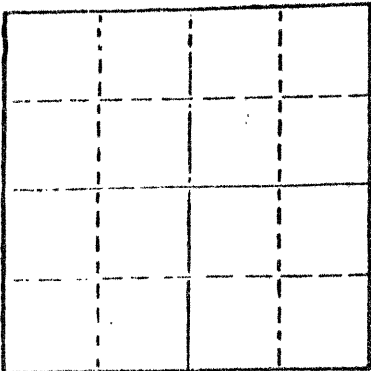

WELL PLUGGING RECORD

Norton County. Sec. 35 Twp. 3S Rge. 23W /E/W
Location as "NE/CNW/SW" or footage from lines
C NW/4 NE/4
Lease Owner Hummon Corporation
Lease Name Frederick Well No. 1
Office Address 400 One Main Place, Wichita, Kansas 67202
Character of Well (Completed as Oil, Gas or Dry Hole) D & A
Date Well completed December 22, 1980
Application for plugging filed December 22, 1980
Application for plugging approved December 22, 1980
Plugging commenced December 22, 1980
Plugging completed December 22, 1980
Reason for abandonment of well or producing formation D & A
If a producing well is abandoned, date of last production 19
Was permission obtained from the Conservation Division or its agents before plugging was commenced? Yes
Name of Conservation Agent who supervised plugging of this well Gil Balthazor
Producing formation Depth to top Bottom Total Depth of Well 13,775'
Show depth and thickness of all water, oil and gas formations.

OIL, GAS OR WATER RECORDS

CASING RECORD

FORMATION	CONTENT	FROM	TO	SIZE	PUT IN	PULLED OUT
				8 5/8"	274.35'	-0-

Describe in detail the manner in which the well was plugged, indicating where the mud fluid was placed and the method or methods used in introducing it into the hold. If cement or other plugs were used, state the character of same and depth placed, from feet to feet for each plug set.

Plugged well @ 900' w/60 sx cement
@ 270' w/30 sx cement
Bridge plug w/10 sx cement
5 sx cement in rathole

DEC 31 1980
CONSERVATION DIVISION
Wichita, Kansas

(If additional description is necessary, use BACK of this sheet)

Name of Plugging Contractor Red Tiger Drilling Company
1720 KSB&T Building, Wichita, Kansas 67202

12-31-80

STATE OF Kansas COUNTY OF Sedgwick ss. contractor
Gloria Fawcett (employee of ~~owner~~ ~~owner or operator~~)
of the above-described well, being first duly sworn on oath, says: That I have knowledge of the facts, statements, and matters herein contained and the log of the above-described well as filed and that the same are true and correct. So help me God.

(Signature) Gloria Fawcett
1720 KSB&T Building, Wichita, Kansas 67202
(Address)

SUBSCRIBED AND SWORN TO before me this 29th day of December, 1980.

My commission expires Notary Public.

