


Give All Information Completely
Make Required Affidavit
Mail or Deliver Report to:
Conservation Division
State Corporation Commission
800 Biting Building
Wichita, Kansas

WELL PLUGGING RECORD

NORTH

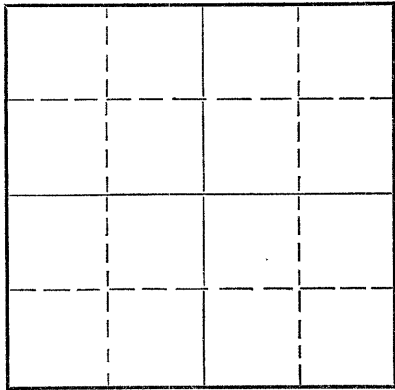

Locate well correctly on above
Section Plat

Norton County. Sec. 34 Twp. 3 Rge. 23 (E) W (W)
Location as "NE/CNW%SW%" or footage from lines SE SE SE
Lease Owner Trans Era Petroleum, Inc.
Lease Name Hershiser Well No. 1
Office Address Russell, Kansas
Character of Well (completed as Oil, Gas or Dry Hole) Dry Hole
Date well completed 9/14/53 19____
Application for plugging filed 9/11/53 19____
Application for plugging approved 9/11/53 19____
Plugging commenced 9/12/53 19____
Plugging completed 9/12/53 19____
Reason for abandonment of well or producing formation Dry Hole

If a producing well is abandoned, date of last production _____ 19____
Was permission obtained from the Conservation Division or its agents before plugging was commenced? Yes

Name of Conservation Agent who supervised plugging of this well Eldon Petty
Producing formation _____ Depth to top _____ Bottom _____ Total Depth of Well 3814 Feet
Show depth and thickness of all water, oil and gas formations.

OIL, GAS OR WATER RECORDS

CASING RECORD

FORMATION	CONTENT	FROM	TO	SIZE	PUT IN	PULLED OUT
				8 5/8"	194'	None

Describe in detail the manner in which the well was plugged, indicating where the mud fluid was placed and the method or methods used in introducing it into the hole. If cement or other plugs were used, state the character of same and depth placed, from _____ feet to _____ feet for each plug set.

PLUGGING RECORD

Layed down drill pipe. Plugged hole. Set bottom plug at 190'. Mixed and ran 20 sacks of cement. Set top plug at 40' with 10 sacks of cement.

(If additional description is necessary, use BACK of this sheet)

Name of Plugging Contractor _____
Address _____

STATE OF KANSAS, COUNTY OF RUSSELL, ss.
H. R. Michaelis (employee of owner) or (owner or operator) of the above-described well, being first duly sworn on oath, says: That I have knowledge of the facts, statements, and matters herein contained and the log of the above-described well as filed and that the same are true and correct. So help me God.


(Signature) H. R. Michaelis
Russell, Kansas
(Address)

SUBSCRIBED AND SWORN TO before me this 23rd day of September, 19 53.

My commission expires 1-30-57.

Maigie Cooper
Notary Public.

24-7368-5 3-53-20M

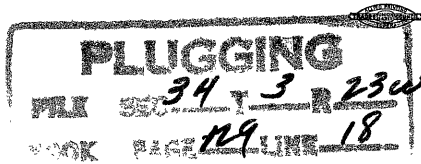

9-29-53
CONSERVATION DIVISION
Wichita, Kansas