

Give All Information Completely  
Make Required Affidavit  
Mail or Deliver Report to:  
Conservation Division  
State Corporation Commission  
212 No. Market  
Wichita, Kansas 67202  
NORTH


WELL PLUGGING RECORD

Norton County, Sec. 29 Twp. 3 Rge. 23 (E) (W)

Location as "NE/CNW%SW%" or footage from lines NW SW NE  
Lease Owner R. P. Nixon Operations, Inc.  
Lease Name Horesky Well No. 1 (OWWO)  
Office Address 754 E. Wichita Avenue Russell, Kansas 67665  
Character of Well (completed as Oil, Gas or Dry Hole) \_\_\_\_\_  
Date well completed \_\_\_\_\_ 19\_\_\_\_  
Application for plugging filed 10-29-70 19\_\_\_\_  
Application for plugging approved 10-30-70 19\_\_\_\_  
Plugging commenced 11-7-70 19\_\_\_\_  
Plugging completed 11-23-70 19\_\_\_\_  
Reason for abandonment of well or producing formation \_\_\_\_\_

If a producing well is abandoned, date of last production \_\_\_\_\_ 19\_\_\_\_  
Was permission obtained from the Conservation Division or its agents before plugging was commenced? Yes

Name of Conservation Agent who supervised plugging of this well W. L. Nichols  
Producing formation \_\_\_\_\_ Depth to top \_\_\_\_\_ Bottom \_\_\_\_\_ Total Depth of Well 3816 Feet  
Show depth and thickness of all water, oil and gas formations.

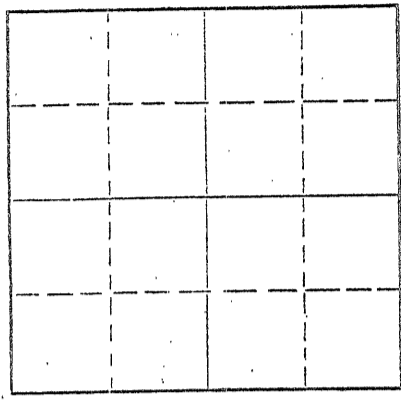

Locate well correctly on above Section Plat

OIL, GAS OR WATER RECORDS

CASING RECORD

FORMATION	CONTENT	FROM	TO	SIZE	PUT IN	PULLED OUT
				8 5/8	200	None
				5 1/2	3812	1119'.67

Describe in detail the manner in which the well was plugged, indicating where the mud fluid was placed and the method or methods used in introducing it into the hole. If cement or other plugs were used, state the character of same and depth placed, from \_\_\_\_\_ feet to \_\_\_\_\_ feet for each plug set.

Moved to location and set in rig. Cleaned cellar. Pushed plug to 3670'; dumped 20 gallons of sand and 5 sacks of cement. Had 12 1/2" tension. Shot casing at 3264'. Spotted oil. Worked casing. Shot casing at 2917', 2624', 2418', 2230' and 2004'. Shot casing at 1627', 1532' and 1396'. Shot casing at 1204' and 1124'. Laid down 35 joints of casing. Tore down and loaded rig. Allied squeezed well with 3 sacks of hulls, 30 sacks of gel and 135 sacks of pozmix cement.

RECEIVED  
STATE CORPORATION COMMISSION  
DEC 7 - 1970  
CONSERVATION DIVISION  
Wichita, Kansas


(If additional description is necessary, use BACK of this sheet)

Name of Plugging Contractor Forbes Casing Pulling Company, Inc. 12-7-70  
Address P. O. Box 221 Great Bend, Kansas 67530

STATE OF Kansas, COUNTY OF Barton, ss.  
James W. Rockhold (employee of owner) or (owner or operator) of the above-described well, being first duly sworn on oath, says: That I have knowledge of the facts, statements, and matters herein contained and the log of the above-described well as filed and that the same are true and correct. So help me God.

(Signature) James W. Rockhold  
P. O. Box 221 Great Bend, Kansas  
(Address)

Subscribed and Sworn before me this 24 day of November, 19 70

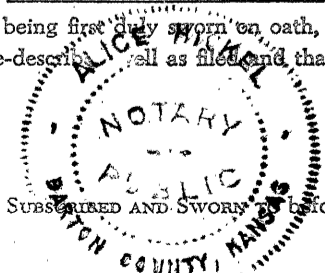

My commission expires May 27, 1973

Notary Public.