

15-137-20099-00-00

FORM CP-4

STATE OF KANSAS
STATE CORPORATION COMMISSION
CONSERVATION DIVISION
P. O. BOX 17027
WICHITA, KANSAS 67217

WELL PLUGGING RECORD

Norton County, Sec. 29 Twp. 3S Rge. (E) 23 (W)

Location as "NE/CNW&SW&" or footage from lines NE NE SE

Lease Owner John P. Jennings

Lease Name HORESKY Well No. #1

Office Address Suite 309, 200 E. First Street, Wichita, Kansas

Character of Well (completed as Oil, Gas or Dry Hole) Dry Hole

Date well completed July 10 1975

Application for plugging filed July 10 1975

Application for plugging approved July 10 1975


Plugging commenced July 10 1975

Plugging completed July 10 1975

Reason for abandonment of well or producing formation No commercial quantity of oil or gas encountered.

If a producing well is abandoned, date of last production 19

Was permission obtained from the Conservation Division or its agents before plugging was commenced? Yes

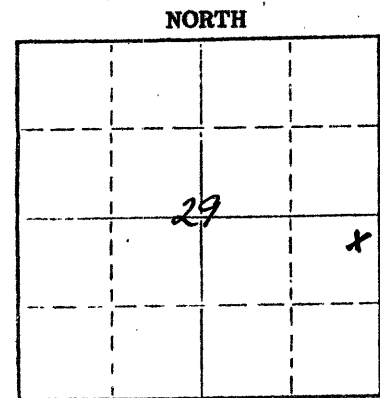

Locate well correctly on above Section Plat

Name of Conservation Agent who supervised plugging of this well Gilbert Balthazor

Producing formation Depth to top Bottom Total Depth of Well 3827'

Show depth and thickness of all water, oil and gas formations.

OIL, GAS OR WATER RECORDS

CASING RECORD

FORMATION	CONTENT	FROM	TO	SIZE	PUT IN	PULLED OUT
				8 5/8"	206'	None

Describe in detail the manner in which the well was plugged, indicating where the mud fluid was placed and the method or methods used in introducing it into the hole. If cement or other plugs were used, state the character of same and depth placed, from feet to feet for each plug set.

1st Plug Set @ 1200' with 70 sx. cement

2nd Plug Set @ 200' with 20 sx. cement

3rd Plug Set @ 40' with 10 sx. cement

RECEIVED
STATE CORPORATION COMMISSION

JUL 17 1975

CONSERVATION DIVISION
Wichita, Kansas

Name of Plugging Contractor Abercrombie Drilling, Inc.

Address 801 Union Center, Wichita, Kansas 67202

STATE OF KANSAS COUNTY OF SEDGWICK ss. Jerry A. Langrehr-Exec. V.P.

(employee of owner) or (owner or operator) of the above-described well, being first duly sworn on oath, says: That I have knowledge of the facts, statements, and matters herein contained and the log of the above-described well as filed and that the same are true and correct. So help me God.

(Signature) Jerry A. Langrehr
801 Union Center, Wichita, Kansas
(Address)

Subscribed and sworn to before me this 16th day of July, 1975

April 8, 1978

Nancy E. Haner

Notary Public.

