


Give All Information Completely  
Make Required Affidavit  
Mail or Deliver Report to:  
Conservation Division  
State Corporation Commission  
800 Bittling Building  
Wichita, Kansas

15-137-00633-00-00  
WELL PLUGGING RECORD

NORTH

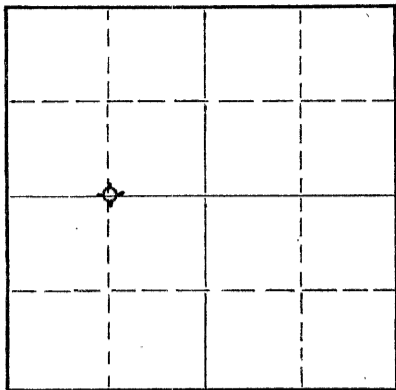

Locate well correctly on above  
Section Plat

Norton County. Sec. 29 Twp. 3 Rge. 23 (E) W (W)  
Location as "NE/CNW%SW%" or footage from lines C N Line SW/4  
Lease Owner D. G. Hansen  
Lease Name Cope Well No. 5  
Office Address Logan, Kansas  
Character of Well (completed as Oil, Gas or Dry Hole) Dry Hole  
Date well completed 3-5 1955  
Application for plugging filed 3-5 1955  
Application for plugging approved 3-5 1955  
Plugging commenced 3-5 1955  
Plugging completed 3-5 1955  
Reason for abandonment of well or producing formation Too low structurally

If a producing well is abandoned, date of last production -- 19  
Was permission obtained from the Conservation Division or its agents before plugging was commenced? Yes

Name of Conservation Agent who supervised plugging of this well Eldon Petty, Hays, Kansas  
Producing formation -- Depth to top -- Bottom -- Total Depth of Well 3950 Feet  
Show depth and thickness of all water, oil and gas formations.

OIL, GAS OR WATER RECORDS

CASING RECORD

FORMATION	CONTENT	FROM	TO	SIZE	PUT IN	PULLED OUT
				8-5/8"	309.05	

Describe in detail the manner in which the well was plugged, indicating where the mud fluid was placed and the method or methods used in introducing it into the hole. If cement or other plugs were used, state the character of same and depth placed, from \_\_\_\_\_ feet to \_\_\_\_\_ feet for each plug set.

Filled hole with mud to 300'; set plug;  
1/2 sack hulls, 15 sacks cement. Filled  
hole with mud to 40'; set plug then filled  
to top with 10 sacks cement, 1/2 sack hulls.

(If additional description is necessary, use BACK of this sheet)

Name of Plugging Contractor C-G Drilling Co.  
Address 107 Rule Building, Wichita, Kansas


STATE OF KANSAS, COUNTY OF SEDGWICK, ss.  
Vicky Jacobs (employee of owner) or (owner or operator) of the above-described well, being first duly sworn on oath, says: That I have knowledge of the facts, statements, and matters herein contained and the log of the above-described well as filed and that the same are true and correct. So help me God.

(Signature) Vicky Jacobs Office Manager  
107 Rule Building, Wichita, Kansas  
(Address)

SUBSCRIBED AND SWORN TO before me this 7th day of March, 1955

My commission expires June 17, 1957

Barbara Donaldson  
Notary Public.

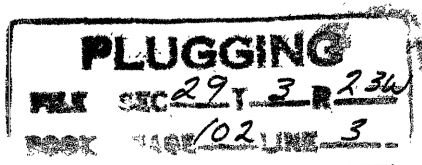

MAR 08 1955 3-8-55  
CONSERVATION DIVISION  
Wichita, Kansas