


15-137-00085-00-00

STATE OF KANSAS
STATE CORPORATION COMMISSION

WELL PLUGGING RECORD

Give All Information Completely
Make Required Affidavit
Mail or Deliver Report to:
Conservation Division
State Corporation Commission
800 Bitting Building
Wichita, Kansas

Norton County. Sec. 29 Twp. 3 Rge. (E) 23(W)
Location as "NE/CNW/SW" or footage from lines SE SE SE
Lease Owner Jones, Shelburne & Farmer, Inc.
Lease Name Horesky Well No. 1
Office Address Russell, Kansas
Character of Well (completed as Oil, Gas or Dry Hole) Dry
Date well completed 12-8- 19.53
Application for plugging filed 12-8 19.53
Application for plugging approved 12-8 19.53
Plugging commenced 12-8 19.53
Plugging completed 12-8 19.53
Reason for abandonment of well or producing formation Dry

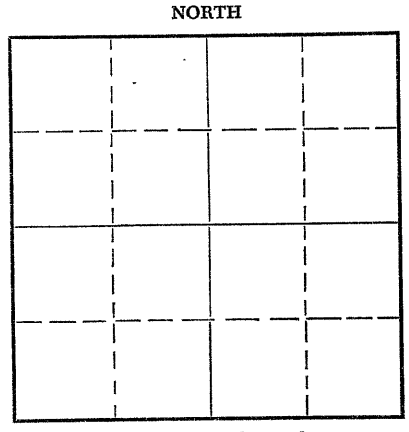

Locate well correctly on above
Section Flat

If a producing well is abandoned, date of last production Never produced 19.
Was permission obtained from the Conservation Division or its agents before plugging was commenced? yes

Name of Conservation Agent who supervised plugging of this well Elden Petty
Producing formation Depth to top Bottom Total Depth of Well 3772 Feet
Show depth and thickness of all water, oil and gas formations.

OIL, GAS OR WATER RECORDS CASING RECORD

FORMATION	CONTENT	FROM	TO	SIZE	PUT IN	PULLED OUT
				8 5/8	280	None

Describe in detail the manner in which the well was plugged, indicating where the mud fluid was placed and the method or methods used in introducing it into the hole. If cement or other plugs were used, state the character of same and depth placed, from feet to feet for each plug set.

1. Filled hole with heavy mud
2. Pushed plug to 280 feet
3. Dumped 1/2 sack hulls on top of plug
4. Mixed 15 sacks cement and dumped on top of hulls
5. Filled hole to top
6. Pushed plug to 40 feet
7. Dumped in 1/2 sack hulls
8. Mixed 10 sacks cement and filled hole to top with same

(If additional description is necessary, use BACK of this sheet)

Name of Plugging Contractor Jones, Shelburne & Farmer, Inc.
Address Russell, Kansas


STATE OF Kansas, COUNTY OF Russell, ss.
John O. Farmer (employee of owner) or (owner or operator) of the above-described well, being first duly sworn on oath, says: That I have knowledge of the facts, statements, and matters herein contained and the log of the above-described well as filed and that the same are true and correct. So help me God.

(Signature) John O. Farmer
Russell, Kansas (Address)

SUBSCRIBED AND SWORN TO before me this 8th day of December, 1953

Bonnie Perryhill
Notary Public.

My commission expires April 23, 1956

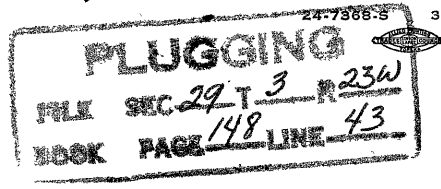

Rec'd
12-15-53