


STATE OF KANSAS
STATE CORPORATION COMMISSION

Give All Information Completely
Make Required Affidavit
Mail or Deliver Report to:
Conservation Division
State Corporation Commission
800 Bitting Building
Wichita, Kansas

15-147-00115-00-00
WELL PLUGGING RECORD

Phillips County, Sec. 16 Twp. 3 Rge. 20W (E) (W)

Location as "NE/CNW/SW" or footage from lines _____
In NW SE NW
Lease Owner Russell Cobb Jr., Inc.
Lease Name Jacob Well No. 1
Office Address Thompson Building Tulsa, Oklahoma
Character of Well (completed as Oil, Gas or Dry Hole) Dry Hole
Date well completed 7-4-54 1954
Application for plugging filed (Verbal approval rec'd) July 4, 1954
Application for plugging approved (Verbal approval rec'd) July 4, 1954
Plugging commenced July 4, 1954
Plugging completed July 4, 1954
Reason for abandonment of well or producing formation Dry hole

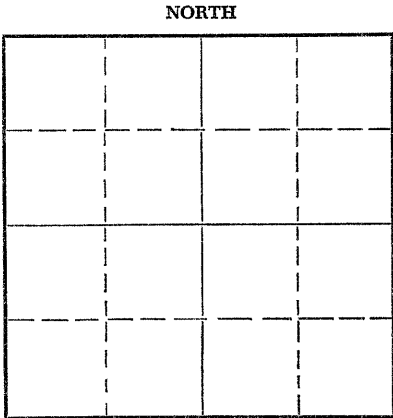

Locate well correctly on above Section Plat

If a producing well is abandoned, date of last production _____ 19____
Was permission obtained from the Conservation Division or its agents before plugging was commenced? yes

Name of Conservation Agent who supervised plugging of this well M. A. Rives
Producing formation _____ Depth to top _____ Bottom _____ Total Depth of Well 3900 Feet
Show depth and thickness of all water, oil and gas formations.

OIL, GAS OR WATER RECORDS

CASING RECORD

FORMATION	CONTENT	FROM	TO	SIZE	PUT IN	PULLED OUT
		0'	215'	8-5/8"	215'	None

Describe in detail the manner in which the well was plugged, indicating where the mud fluid was placed and the method or methods used in introducing it into the hole. If cement or other plugs were used, state the character of same and depth placed, from _____ feet to _____ feet for each plug set.

Plugged hole with 15 sacks cement 1/2 sack hull mixed and poured through drill pipe on bottom. Plug set at 200'. 10 sacks cement 1/2 sack hulls on top plug set set at 45'

07-15-1954

(If additional description is necessary, use BACK of this sheet)
Name of Plugging Contractor Birmingham-Bartlett Drilling Co.
Address 300 Kaufman Building, Wichita 2, Kansas

STATE OF Kansas, COUNTY OF Sedgwick, ss.
Richard Hindery, partner of Birmingham-Bartlett Drilling Co. (employee of owner) or (owner or operator) of the above-described well, being first duly sworn on oath, says: That I have knowledge of the facts, statements, and matters herein contained and the log of the above-described well as filed and that the same are true and correct. So help me God. BIRMINGHAM-BARTLETT DRILLING CO.

(Signature) By Richard Hindery
300 Kaufman Building, Wichita 2, Kansas
(Address)

SUBSCRIBED AND SWORN TO before me this 6th day of July, 1954

My commission expires October 2, 1954
Beverly L. ...
Notary Public.

24-7368-5 3-53-20M

PLUGGING

16 3 200

46 37

PAGE 46 LINE 37

15-147-00115-00-00

JOCOB NO. 1 WELL

LOCATION: In NW SE NW Section 16-38-R20W COMMENCED: 6-25-54
 Phillips Co., Kansas COMPLETED: 7-4-54

OPERATOR: Russell Cobb, Jr., Inc.
 Thompson Bldg.
 Tulsa, Oklahoma

CONTRACTOR: Birmingham-Bartlett Drilling Co.
 300 Kaufman Building
 Wichita 2, Kansas

SURFACE CASING: 8-5/8" 24# surface casing cemented at 215'
 with 175 sacks cement and 2c.c.

OIL STRING: None set. D & A

LOG

(Figures indicate bottom of formation)

0	- 215	Clay, Shale & Shells
	230	Cement
	1340	Shale, Shells & Sand
	1440	Sand & Shale
	1465	Anhydrite
	1750	Sand & Shale
	2610	Shale & Shell
	3465	Shale & Lime
	3780	Lime
	3878	Lime & Shale
	3900	Arbuckle
	3900	Total Depth - D & A

The undersigned, Richard Hindery, one of the partners of Birmingham-Bartlett Drilling Co., hereby certifies that the above is a true and correct log of the formations encountered in drilling of the Jacob #1 Well as shown in the daily drilling reports.

BIRMINGHAM-BARLETT DRILLING CO.

By Richard Hindery

Subscribed and sworn to before me this 6th day of July, 1954

Beverly Pearson
Notary Public

My commission expires: October 2, 1954

PLUGGING
 FILE SEC 16 T 3 R 20W
 BOOK PAGE 46 LINE 37