


STATE OF KANSAS
STATE CORPORATION COMMISSION

15-137-00202-00-00

WELL PLUGGING RECORD

Give All Information Completely
Make Required Affidavit
Mail or Deliver Report to:
Conservation Division
State Corporation Commission
800 Bitting Building
Wichita, Kansas

Norton County. Sec. 28 Twp. 3 Rge. 23 XXXX (E) (W)
Location as "NE/CNW%SW%" or footage from lines NE NE SW
Lease Owner K & E Drilling, Inc. - Geo. P. Vye
Lease Name Horesky Well No. #1
Office Address 1006 Central Bldg., Wichita, Kansas
Character of Well (completed as Oil, Gas or Dry Hole) dry hole
Date well completed November 21, 19 55
Application for plugging filed November 21, 19 55
Application for plugging approved November 21 19 55
Plugging commenced November 21, 19 55
Plugging completed November 21, 19 55
Reason for abandonment of well or producing formation commercial quantities of oil not found

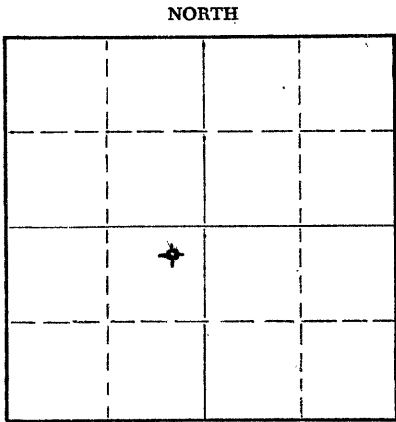

Locate well correctly on above Section Plat

If a producing well is abandoned, date of last production _____ 19____
Was permission obtained from the Conservation Division or its agents before plugging was commenced? yes

Name of Conservation Agent who supervised plugging of this well Eldon Petty
Producing formation _____ Depth to top _____ Bottom _____ Total Depth of Well _____ Feet
Show depth and thickness of all water, oil and gas formations.

OIL, GAS OR WATER RECORDS				CASING RECORD		
FORMATION	CONTENT	FROM	TO	SIZE	PUT IN	PULLED OUT
				8 5/8	304'	none

Describe in detail the manner in which the well was plugged, indicating where the mud fluid was placed and the method or methods used in introducing it into the hole. If cement or other plugs were used, state the character of same and depth placed, from _____ feet to _____ feet for each plug set.

Filled hole with heavymud from 3825 to 290'. Set wooden plug with 15 sacks cement. Second plug at 40' and capped with 10 sacks cement.

Name of Plugging Contractor K & E Drilling, Inc. (If additional description is necessary, use BACK of this sheet)
Address 1006 Central Bldg., Wichita, Kansas 11-30-55

STATE OF Kansas, COUNTY OF Sedgwick, ss.
Dale Silcott (employee of owner) or ~~owner or operator~~ of the above-described well, being first duly sworn on oath, says: That I have knowledge of the facts, statements, and matters herein contained and the log of the above-described well as filed and that the same are true and correct. So help me God.
(Signature) Dale Silcott
1006 Central Bldg., Wichita, Kansas (Address)

SUBSCRIBED AND SWORN to before me this 28th day of November, 19 55
My commission expires June 25, 1956
Francis Walker Notary Public.

