


STATE OF KANSAS
STATE CORPORATION COMMISSION

Give All Information Completely
Make Required Affidavit
Mail or Deliver Report to:
Conservation Division
State Corporation Commission
211 No. Broadway
Wichita, Kansas

15-137-00259-00-00
WELL PLUGGING RECORD

NORTH

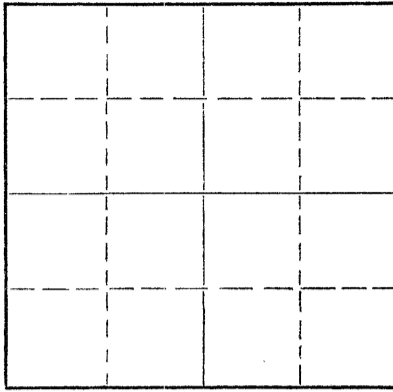

Locate well correctly on above
Section Plat

Norton County. Sec. 20 Twp. 3 Rge. (E) 23 (W)

Location as "NE/CNW/SW" or footage from lines NW NW SW
Lease Owner Jones, Shelburne & Farmer, Inc.
Lease Name ANKENMAN C Well No. 1
Office Address Russell, Kansas
Character of Well (completed as Oil, Gas or Dry Hole) Dry
Date well completed 4-16 1956
Application for plugging filed 4-16 1956
Application for plugging approved 4-16 1956
Plugging commenced 4-16 1956
Plugging completed 4-16 1956
Reason for abandonment of well or producing formation Dry

If a producing well is abandoned, date of last production _____ 19____
Was permission obtained from the Conservation Division or its agents before plugging was commenced? Yes

Name of Conservation Agent who supervised plugging of this well Eldon Petty
Producing formation _____ Depth to top _____ Bottom _____ Total Depth of Well 3765 Feet
Show depth and thickness of all water, oil and gas formations.

OIL, GAS OR WATER RECORDS

CASING RECORD

FORMATION	CONTENT	FROM	TO	SIZE	PUT IN	PULLED OUT
				8-5/8"	250	None

Describe in detail the manner in which the well was plugged, indicating where the mud fluid was placed and the method or methods used in introducing it into the hole. If cement or other plugs were used, state the character of same and depth placed, from _____ feet to _____ feet for each plug set.

1. Filled hole with heavy mud
2. Pushed plug to 240'
3. Dumped 1/2 sack hulls on top of plug
4. Mixed 15 sacks cement and dumped on top of hulls
5. Filled hole to top
6. Pushed plug to 40'
7. Dumped in 1/2 sack hulls
8. Mixed 10 sacks cement and filled hole to top with same.

(If additional description is necessary, use BACK of this sheet)

Name of Plugging Contractor Jones, Shelburne & Farmer, Inc.
Address Russell, Kansas


STATE OF Kansas, COUNTY OF Russell, ss.
JOHN O. FARMER (employee of owner) or (owner or operator) of the above-described well, being first duly sworn on oath, says: That I have knowledge of the facts, statements, and matters herein contained and the log of the above-described well as filed and that the same are true and correct. So help me God.

(Signature) John O. Farmer
Russell, Kansas
(Address)

SUBSCRIBED AND SWORN TO before me this 25th day of April, 1956

My commission expires 10-11-58

Lucille Kennedy
Notary Public.

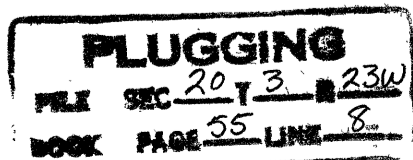

APR 30 1956
04-30-1956
CONSERVATION DIVISION
Wichita, Kansas


OPERATOR Jones, Shelburne & Farmer, Inc.

15-137-00259-00-00

FORMATION RECORD

ADDRESS Russell, Kansas

Give detailed description and thickness of all formations drilled through, contents of sand, whether dry, water, oil or gas.

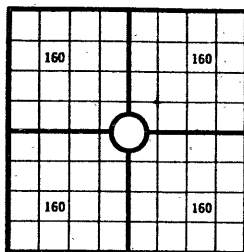640 Acres
N

Locate well correctly

COUNTY Norton SEC. 20 TWP. 3 RGE. 23COMPANY OPERATING Jones, Shelburne & Farmer, Inc.OFFICE ADDRESS Russell, KansasFARM NAME ANKENMAN C WELL NO. 1DRILLING STARTED 4-7, 56 DRILLING FINISHED 4-16, 56

DATE OF FIRST PRODUCTION _____ COMPLETED _____

WELL LOCATED NW 1/4 NW 1/4 SW 1/4 North of South

Line and _____ ft. East of West Line of Quarter Section

Elevation (Relative to sea level) DERRICK FLOOR 2407 GROUND 2404CHARACTER OF WELL (Oil, gas or dryhole) Dry

OIL OR GAS SANDS OR ZONES

Name	From	To	Name	From	To
1			4		
2			5		
3			6		

Perforating Record If Any

Shot Record

Formation	From	To	No. of Shots	Formation	From	To	Size of Shot

CASING RECORD

Amount Set						Amount Pulled				Packer Record	
Size	Wt.	Thds.	Make	Ft.	In.	Ft.	In.	Size	Length	Depth Set	Make
5/8				250							

Liner Record: Amount _____ Kind _____ Top _____ Bottom _____

CEMENTING AND MUDDING

Size	Amount Set		Sacks Cement	Chemical		Method of Cementing	Amount	Mudding Method	Results (See Note)
	Ft.	In.		Gal.	Make				
5/8	250		125						

Note: What method was used to protect sands if outer strings were pulled? _____

NOTE: Were bottom hole plugs used? _____ If so, state kind, depth set and results obtained _____

TOOLS USED

Rotary Tools were used from _____ feet to _____ Cable tools were used from _____ feet to _____ feet, and from _____ feet to _____ feet, and from _____ feet to _____ feet to _____

Type Rig _____

INITIAL PRODUCTION TEST

Describe initial test: whether by flow through tubing or casing or by pumping _____

Amount of Oil Production _____ bbls. Size of choke, if any _____ Length of test _____ Water

Production _____ bbls. Gravity of oil _____ Type of Pump if pump is used, describe _____

Formation	Top	Bottom	Formation	Top	Bottom
Surface	0	250			
Shale	250	750			
Shale & sand	750	1750			
Shale & Redbed	1750	1993			
Anhydrite	1993	2023			
Shale & shells	2023	2415			
Shale & lime	2415	2610			
Lime & shale	2610	3690			
Shale & lime	3690	3725			
Granite Wash	3725	3765			
T.D.		3765			

TOPS:

Elevation DF 2407: RB2409

Anhydrite 1993
 Heebner 3442
 Toronto 3470
 Lansing -1073 3482
 Granite Wash 3719
 Granite 3763
 T.D. 3765

D & A

PLUGGING
 FW SEC 20 T 3 R 23 W

I, the undersigned, being first duly sworn upon oath, state that this well record is true, correct and complete according to the records of this office and to the best of my knowledge and belief.

John Farmer
 Vice-Pres.
 Name and title of representative of company

Subscribed and sworn to before me this 25th day of April 19 56
 My Commission expires 10-11-58
Lucille E. Gandy
 Notary Public

FARM NAME ANKENMAN C WELL NO. 1 COUNTY Norton SEC. 20 TWP. 3 RGE. 23