

19-137-20138-06-00


STATE OF KANSAS
STATE CORPORATION COMMISSION

WELL PLUGGING RECORD

Give All Information Completely
Make Required Affidavit
Mail or Deliver Report to
Conservation Division
State Corporation Comm.
245 North Water
Wichita, KS 67202

Norton County, Sec. 4 Twp. 3S., Rge. 24 /W
Location as "NE/CNW $\frac{1}{4}$ /SW $\frac{1}{4}$ " or footage from lines center
NW $\frac{1}{4}$ NW $\frac{1}{4}$, NW $\frac{1}{4}$

Lease Owner Norco Petroleum
Lease Name James A. Maddy Well No. 1
Office Address 11208 North 84th, Scottsdale, Arizona
Character of Well (Completed as Oil, Gas or Dry Hole) Dry Hole

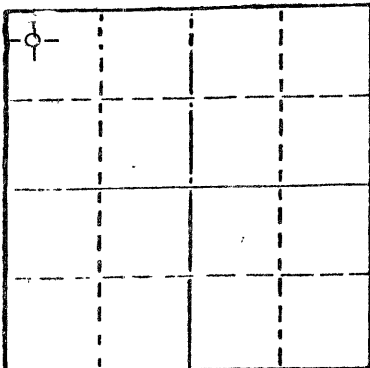

Locate well correctly on above
Section Plat

Date Well completed 3 January 1979
Application for plugging filed 2 January 1979
Application for plugging approved 2 January 1979
Plugging commenced 2 January 1979
Plugging completed 3 January 1979
Reason for abandonment of well or producing formation Non productive

If a producing well is abandoned, date of last production 19

Was permission obtained from the Conservation Division or its agents before plugging was commenced? Yes

Name of Conservation Agent who supervised plugging of this well Gilber Balthazor
Producing formation _____ Depth to top 3402 Bottom _____ Total Depth of Well 3700
Show depth and thickness of all water, oil and gas formations.

OIL, GAS OR WATER RECORDS

CASING RECORD

FORMATION	CONTENT	FROM	TO	SIZE	PUT IN	PULLED OUT
Surface Casing		-0-	207	8-5/8"	207	-0-
Lansing	Oil Show	3400'	3402'	-0-	-0-	-0-

Describe in detail the manner in which the well was plugged, indicating where the mud fluid was placed and the method or methods used in introducing it into the hold. If cement or other plugs were used, state the character of same and depth placed, from _____ feet to _____ feet for each plug set.

Hole full of heavy mud.

Plug No. 1 - 70 sx cement at 1000'

Plug No. 2 - 20 sx cement at 200'

Plug No. 3 - 10 sx cement from 40' to surface.

Placed 5 sx cement - plug in top of rat hole.

RECEIVED
STATE CORPORATION COMMISSION

JAN 22 1979

CONSERVATION DIVISION
Wichita, Kansas

1-22-79

(If additional description is necessary, use BACK of this sheet)

Name of Plugging Contractor Murfin Drilling Company
617 Union Center, Wichita, Kansas 67202

STATE OF Arizona COUNTY OF Maricopa, ss.
Charles R. Paynter (employee of owner) or (owner or operator)
of the above-described well, being first duly sworn on oath, says: That I have knowledge of the facts, statements, and matters herein contained and the log of the above-described well as filed and that the same are true and correct. So help me God.

(Signature)

Charles R. Paynter
11208 N. 84th St. Scottsdale, Az. 85260
(Address)

SUBSCRIBED AND SWORN TO before me this 18th day of January, 1979

Shirley A. Scheckenback
Notary Public.

My commission expires 3-3-79

WELL LOG

15-137-20138-00-00

COMPANY Norco Petroleum

SEC. 4 T. 3S R. 24W
LOC. NW NW NW

FARM JAMES A. MADDY NO. 1

RIG. NO. 7


TOTAL DEPTH 3700'

COUNTY Norton
KANSAS

COMM. 12-27-78

COMP. 1-3-79

CONTRACTOR Murfin Drilling Company

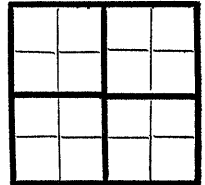

CASING

20 10
15 8 -5/8" @ 212' w/175 sx.
12 6
13 5

ELEVATION

PRODUCTION

FIGURES INDICATE BOTTOM OF FORMATIONS

170'	Surface soils, Sand & Rock
210'	Shale
320'	Sand & Shale
1360'	Shale
1963'	Shale & Sand
1992'	Anhydrite
2875'	Shale
3280'	Shale & Lime
3410'	Lime & Shale
3593'	Shale & Lime
3615'	Lime & Shale
3700'	Lime RTD

RECEIVED
STATE CORPORATION COMMISSION
FEB - 9 1979
CONSERVATION DIVISION
Wichita, Kansas
2-9-79

State of KANSAS
County of SEDGWICK ss:

I, Wm. S. Shropshire of the Murfin Drilling Company

upon oath state that the above and foregoing is a true and correct copy of the log of the JAMES A. MADDY #1 well.

Wm. S. Shropshire
Wm. S. Shropshire, Asst. Gen. Mgr.

Subscribed and sworn to before me this 31st day of January 19 79

My Commission Expires:

SANDRA KAY MAY
NOTARY PUBLIC
Butler County, Kansas
My Appt. Exp. 6-5-80

Sandra Kay May
NOTARY PUBLIC
Sandra Kay May