


Give All Information Completely
Make Required Affidavit
Mail or Deliver Report to:
Conservation Division
State Corporation Commission
212 North Market, Insurance Bldg.
Wichita, Kansas

WELL PLUGGING RECORD

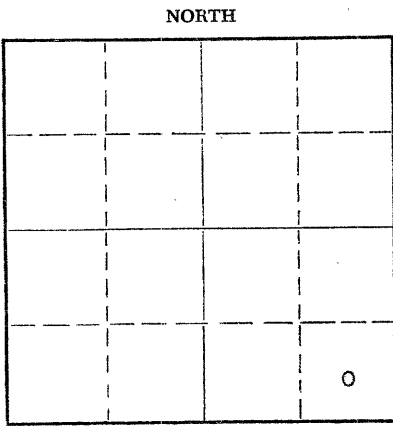

Locate well correctly on above Section Plat

Norton County, Sec. 6 Twp. 3S Rge. 24 (X) W (W)

Location as "NE/CNW/SW" or footage from lines C SE SE

Lease Owner Richard G. Smith

Lease Name Rule Well No. 1

Office Address 602 Rule Building, Wichita, Kansas

Character of Well (completed as Oil, Gas or Dry Hole) Dry Hole

Date well completed November 9 1965

Application for plugging filed November 9 1965

Application for plugging approved November 9 1965

Plugging commenced November 9 1965

Plugging completed November 9 1965

Reason for abandonment of well or producing formation Dry Hole

If a producing well is abandoned, date of last production 19

Was permission obtained from the Conservation Division or its agents before plugging was commenced? Yes

Name of Conservation Agent who supervised plugging of this well Mr. W. L. Nichols, Moreland, Kansas

Producing formation _____ Depth to top _____ Bottom _____ Total Depth of Well _____ Feet

Show depth and thickness of all water, oil and gas formations.

OIL, GAS OR WATER RECORDS

CASING RECORD

FORMATION	CONTENT	FROM	TO	SIZE	PUT IN	PULLED OUT
0-220	Soil clay & gravel	0	220	8 5/8"	241	None

Describe in detail the manner in which the well was plugged, indicating where the mud fluid was placed and the method or methods used in introducing it into the hole. If cement or other plugs were used, state the character of same and depth placed, from _____ feet to _____ feet for each plug set.

1. Filled hole with heavy mud to 550 feet; Placed plug @ 550 with 20 sacks cement displaced through drill pipe on top the plug
2. Filled hole with heavy mud to 225; Placed plug @ 225 with 1/4 sack hulls on top and 20 sacks cement displaced through drill pipe on top the plug
3. Filled hole with heavy mud to 40 feet; Placed plug @ 40 with 1/4 sack hulls on top and 10 sacks cement on plug.

RECEIVED
STATE CORPORATION COMMISSION
NOV 18 1965

WICHITA, KANSAS

11-18-65

(If additional description is necessary, use BACK of this sheet)


Name of Plugging Contractor Ja-Le Contracting, Inc.
Address Great Bend, Kansas

STATE OF KANSAS, COUNTY OF SEDGWICK, ss.

Richard G. Smith (Employee of owner or owner or operator) of the above-described well, being first duly sworn on oath, says: That I have knowledge of the facts, statements and matters herein contained and the log of the above-described well as filed and that the same are true and correct. So help me God.

(Signature) Richard G. Smith
602 Rule Building, Wichita, Kansas
(Address)

Subscribed and sworn to before me this 12th day of November, 1965

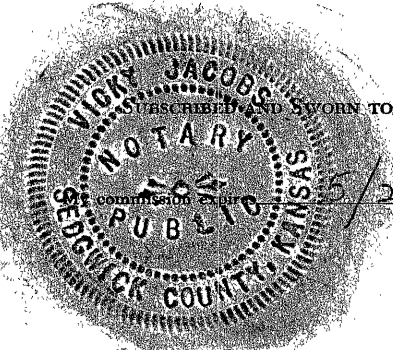

12/20/67

Wicky Jacobs
Notary Public.