

13-137-00255-00-00


STATE OF KANSAS
STATE CORPORATION COMMISSION

WELL PLUGGING RECORD

Give All Information Completely
Make Required Affidavit
Mail or Deliver Report to:
Conservation Division
State Corporation Commission
800 Biting Building
Wichita, Kansas

Norton County, Sec. 6 Twp. 3 Rge. 24 (E) (W)

Location as "NE/CNW/SW" or footage from lines _____
Lease Owner Sauvage-Dunn Drilling Co., Inc.
Lease Name Collins Well No. 1
Office Address Oberlin, Kansas
Character of Well (completed as Oil, Gas or Dry Hole) dry hole
Date well completed 4-22 19 56
Application for plugging filed 4-23 19 56
Application for plugging approved 4-23 19 56
Plugging commenced 4-23 19 56
Plugging completed 4-23 19 56
Reason for abandonment of well or producing formation _____
dry hole

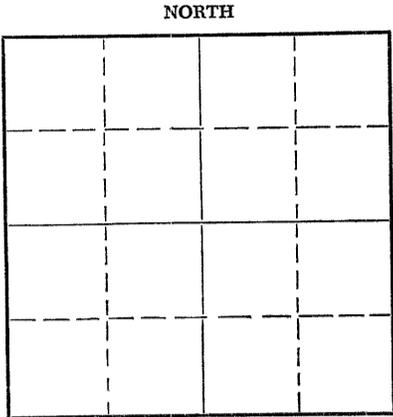

Locate well correctly on above
Section Flat

If a producing well is abandoned, date of last production _____ 19 _____
Was permission obtained from the Conservation Division or its agents before plugging was commenced? yes

Name of Conservation Agent who supervised plugging of this well Eldon Petty
Producing formation _____ Depth to top _____ Bottom _____ Total Depth of Well 3740 Feet
Show depth and thickness of all water, oil and gas formations.

OIL, GAS OR WATER RECORDS

CASING RECORD

FORMATION	CONTENT	FROM	TO	SIZE	PUT IN	PULLED OUT

Describe in detail the manner in which the well was plugged, indicating where the mud fluid was placed and the method or methods used in introducing it into the hole. If cement or other plugs were used, state the character of same and depth placed, from _____ feet to _____ feet for each plug set.

Filled hole with heavy mud thru drill pipe pulled drill pipe to 130 feet set plug mixed 1/2 sx hulls 15 sx cement. filled hole with heavy mud set 2nd plug at 110 feet mixed 1/2 sx hulls and 10 sx cement filled hole to bottom of cellar.

(If additional description is necessary, use BACK of this sheet)

Name of Plugging Contractor Sauvage & Dunn Drilling Co., Inc.
Address Oberlin, Kansas

STATE OF Kansas, COUNTY OF Decatur, ss.
Sauvage-Dunn Drilling Co. (employee of owner) or (owner or operator) of the above-described well, being first duly sworn on oath, says: That I have knowledge of the facts, statements, and matters herein contained and the log of the above-described well as filed and that the same are true and correct. So help me God.

(Signature) [Signature]
Oberlin, Kansas (Address)

SUBSCRIBED AND SWORN TO before me this 24th day of April, 19 56

My commission expires May 17, 1959

24-7368-S 3-53-20M

RECEIVED Notary Public
STATE CORPORATION COMMISSION

APR 27 1956

CONSERVATION DIVISION
Wichita, Kansas

4-27-56

PLUGGING
FILE SEC 6 T 3 R 24w
BOOK PAGE 57 LINE 23