


15137-0013100-00

WELL PLUGGING RECORD

Give All Information Completely  
Make Required Affidavit  
Mail or Deliver Report to:  
Conservation Division  
State Corporation Commission  
800 Bitting Building  
Wichita, Kansas

Norton County. Sec. 29 Twp. 3S Rge. (E) 24 (W)

Location as "NE/CNW $\frac{1}{4}$ SW $\frac{1}{4}$ " or footage from lines SW SW SE  
Lease Owner Jones, Shelburne & Farmer, Inc.  
Lease Name Ankenman Well No. 1  
Office Address Russell, Kansas  
Character of Well (completed as Oil, Gas or Dry Hole) Dry  
Date well completed 4-11 19 54  
Application for plugging filed 4-11 19 54  
Application for plugging approved 4-11 19 54  
Plugging commenced 4-11 19 54  
Plugging completed 4-11 19 54  
Reason for abandonment of well or producing formation Dry

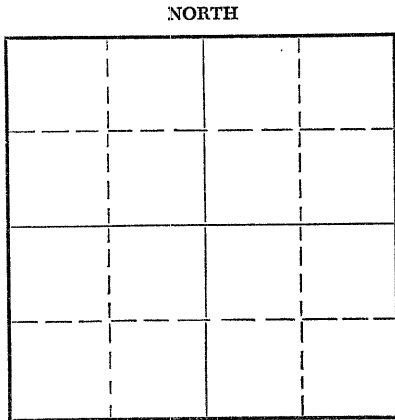

Locate well correctly on above Section Plat

If a producing well is abandoned, date of last production Never produced 19  
Was permission obtained from the Conservation Division or its agents before plugging was commenced? yes

Name of Conservation Agent who supervised plugging of this well Elden Petty  
Producing formation \_\_\_\_\_ Depth to top \_\_\_\_\_ Bottom \_\_\_\_\_ Total Depth of Well 3811 Feet  
Show depth and thickness of all water, oil and gas formations.

OIL, GAS OR WATER RECORDS

CASING RECORD

FORMATION	CONTENT	FROM	TO	SIZE	PUT IN	PULLED OUT
				8 5/8	290	None

Describe in detail the manner in which the well was plugged, indicating where the mud fluid was placed and the method or methods used in introducing it into the hole. If cement or other plugs were used, state the character of same and depth placed, from \_\_\_\_\_ feet to \_\_\_\_\_ feet for each plug set.

1. Filled hole with heavy mud
2. Pushed plug to 280'
3. Dumped  $\frac{1}{2}$  sack hulls on top of plug
4. Mixed 15 sacks cement and dumped on top of hulls
5. Filled hole to top
6. Pushed plug to 40'
7. Dumped in  $\frac{1}{2}$  sack hulls
8. Mixed 10 sacks cement and filled hole to top with same

(If additional description is necessary, use BACK of this sheet)

Name of Plugging Contractor Jones, Shelburne & Farmer, Inc.  
Address Russell, Kansas

STATE OF Kansas, COUNTY OF Russell, ss.  
John O. Farmer

(employee of owner) or (owner or operator) of the above-described well, being first duly sworn on oath, says: That I have knowledge of the facts, statements, and matters herein contained and the log of the above-described well as filed and that the same are true and correct. So help me God.


(Signature) John O. Farmer  
Russell, Kansas (Address)

SUBSCRIBED AND SWORN TO before me this 13th day of April, 1954

My commission expires April 23, 1956

Bonnie Berryhill  
Notary Public.

24-7366-S 3-53-20M

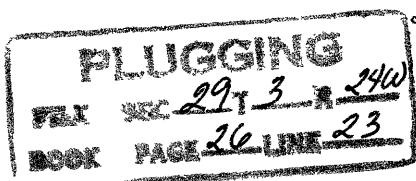

4-16-54

OPERATOR Jones, Shelburne & Farmer, Inc.

FORMATION RECORD

ADDRESS Russell, Kansas

Give detailed description and thickness of all formations drilled through, contents of sand, whether dry, water, oil or gas.

640 Acres  
N

160				160
160				160

Locate well correctly

COUNTY Norton, SEC. 29, TWP. 3, RGE. 24  
 COMPANY OPERATING Jones, Shelburne & Farmer, Inc.  
 OFFICE ADDRESS Russell, Kansas  
 FARM NAME Arkansas WELL NO. 1  
 DRILLING STARTED 4-3, 1954, DRILLING FINISHED 4-30, 1954  
 DATE OF FIRST PRODUCTION \_\_\_\_\_ COMPLETED \_\_\_\_\_  
 WELL LOCATED SW  $\frac{1}{4}$  SW  $\frac{1}{4}$  SE  $\frac{1}{4}$ , North of South  
 Line and \_\_\_\_\_ ft. East of West Line of Quarter Section  
 Elevation (Relative to sea level) DERRICK FLOOR 2100 GROUND \_\_\_\_\_  
 CHARACTER OF WELL (Oil, gas or dryhole) Dry

## OIL OR GAS SANDS OR ZONES

Name	From	To	Name	From	To
1			4		
2			5		
3			6		

## Perforating Record if Any

## Shot Record

Formation	From	To	No. of Shots	Formation	From	To	Size of Shot

## CASING RECORD

Amount Set				Amount Pulled				Packer Record			
Size	Wt.	Thds.	Make	Ft.	In.	Ft.	In.	Size	Length	Depth Set	Make
8 5/8				200							

Liner Record: Amount \_\_\_\_\_ Kind \_\_\_\_\_ Top \_\_\_\_\_ Bottom \_\_\_\_\_

## CEMENTING AND MUDDING

Size	Amount Set		Sacks Cement	Chemical		Method of Cementing	Amount	Mudding Method	Results (See Note)
	Ft.	In.		Gal.	Make				
8 5/8	200		70						

Note: What method was used to protect sands if outer strings were pulled? \_\_\_\_\_

NOTE: Were bottom hole plugs used? \_\_\_\_\_ If so, state kind, depth set and results obtained \_\_\_\_\_

## TOOLS USED

Rotary Tools were used from \_\_\_\_\_ feet to \_\_\_\_\_ Cable tools were used from \_\_\_\_\_ feet to \_\_\_\_\_  
 feet, and from \_\_\_\_\_ feet to \_\_\_\_\_ feet, and from \_\_\_\_\_ feet to \_\_\_\_\_

Type Rig \_\_\_\_\_

## INITIAL PRODUCTION TEST

Describe initial test: whether by flow through tubing or casing or by pumping \_\_\_\_\_

Amount of Oil Production \_\_\_\_\_ bbls. Size of choke, if any \_\_\_\_\_ Length of test \_\_\_\_\_ Water  
 Production \_\_\_\_\_ bbls. Gravity of oil \_\_\_\_\_ Type of Pump if pump is used, describe \_\_\_\_\_

Formation	Top	Bottom	Formation	Top	Bottom
Shale	0	200			
Sand & shale	200	1615			
Sand	1615	1735			
Shale & shells	1735	1967			
Anhydrite	1967	1995			
Shale & shells	1995	2100			
Shale & shells	2100	2325			
Line & shale	2325	3505			
Line	3505	3700			
Shale & line	3700	3746			
Granite Wash	3746	3769			
Granite	3769	3811			

**PLUGGING**  
 HJ SEC 29 T 3 R 24W  
 BOX PAGE 26 LINE 23

## TOPS:

Elevation 2102 ft. B.  
 Hoobner 3395  
 Lansing 3430  
 Base K. C. 3619  
 Megan Sand 3715  
 Granite Wash 3746  
 Granite 3769  
 T. D. 3811

**RECEIVED**  
 STATE CORPORATION COMMISSION

MAY 6 - 1954

CONSERVATION DIVISION  
 Wichita, Kansas

I, the undersigned, being first duly sworn upon oath, state that this well record is true, correct and complete according to the records of this office and to the best of my knowledge and belief.

John Farmer  
 Name and title of representative of company

Subscribed and sworn to before me this 13th day of April, 1954  
 My Commission expires April 23, 1956  
Bonnie Plushell  
 Notary Public.

15-137-00131-00-00

5-6-54

FARM NAME Arkansas WELL NO. 1 COUNTY Norton SEC. 29 TWP. 3 RGE. 24