

15-137-00005-00-00

STATE OF KANSAS
STATE CORPORATION COMMISSION


WELL PLUGGING RECORD

Give All Information Completely
Make Required Affidavit
Mail or Deliver Report to:
Conservation Division
State Corporation Commission
212 North Market, Insurance Bldg.
Wichita, Kansas

Norton County, Sec. 29 Twp. 3S Rge. 24 (E) W (W)

Location as "NE/CNW $\frac{1}{2}$ SW $\frac{1}{2}$ " or footage from lines NE NE SE
Lease Owner C-G Drilling Co.
Lease Name Ankenman "A" Well No. 1
Office Address 107 Rule Building, Wichita 2, Kansas
Character of Well (completed as Oil, Gas or Dry Hole) Dry Hole
Date well completed May 9 19 62
Application for plugging filed May 9 19 62
Application for plugging approved May 9 19 62
Plugging commenced May 9 19 62
Plugging completed May 9 19 62
Reason for abandonment of well or producing formation Too low structurally

NORTH

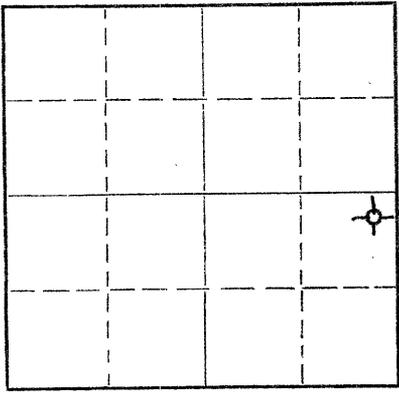

Locate well correctly on above
Section Plat

If a producing well is abandoned, date of last production 19
Was permission obtained from the Conservation Division or its agents before plugging was commenced? Yes

Name of Conservation Agent who supervised plugging of this well Eldon Petty, Hays, Kansas
Producing formation _____ Depth to top _____ Bottom _____ Total Depth of Well 3730 Feet
Show depth and thickness of all water, oil and gas formations.

OIL, GAS OR WATER RECORDS

CASING RECORD

FORMATION	CONTENT	FROM	TO	SIZE	PUT IN	PULLED OUT
				8-5/8"	290.66'	None

Describe in detail the manner in which the well was plugged, indicating where the mud fluid was placed and the method or methods used in introducing it into the hole. If cement or other plugs were used, state the character of same and depth placed, from _____ feet to _____ feet for each plug set.

Filled hole with heavy mud to 285'. Set Plug. Put in 25 sacks cement. Filled with heavy mud to 40'. Set plug. Filled to top with 1 sack hulls and 10 sacks cement.

RECEIVED
STATE CORPORATION COMMISSION

MAY 17 1962

CONSERVATION DIVISION
Wichita, Kansas

5-17-62

(If additional description is necessary, use BACK of this sheet)

Name of Plugging Contractor C-G Drilling Co.
Address 107 Rule Building, Wichita 2, Kansas

STATE OF KANSAS, COUNTY OF SEDGWICK, ss.
G. F. Galloway (employee of owner) or (owner or operator) of the above-described well, being first duly sworn on oath, says: That I have knowledge of the facts, statements, and matters herein contained and the log of the above-described well as filed and that the same are true and correct. So help me God.

(Signature) G. F. Galloway
107 Rule Building
(Address)

Subscribed and Sworn to before me this 16th day of May 19 62
My Commission expires May 20, 1963
Vicky Jacobs
Notary Public.

