


WELL PLUGGING RECORD

Give All Information Completely
Make Required Affidavit
Mail or Deliver Report to:
Conservation Division
State Corporation Commission
800 Bittling Building
Wichita, Kansas

Norton County. Sec. 32 Twp. 3S Rge. 24 (E) W (W)
Location as "NE/CNW/SW" or footage from lines SE SE SE
Lease Owner C-G DRILLING CO. & AURORA GASOLINE COMPANY
Lease Name Brunson Well No. I
Office Address 107 Rule Bldg., Wichita, Kansas
Character of Well (completed as Oil, Gas or Dry Hole) dry hole
Date well completed June 20, 19 55
Application for plugging filed June 20 19 55
Application for plugging approved June 20 19 55
Plugging commenced June 20 19 55
Plugging completed June 20 19 55
Reason for abandonment of well or producing formation Too low structurally

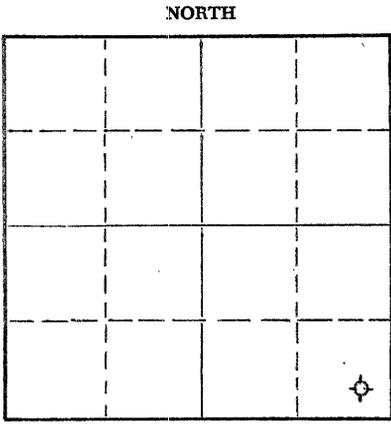

Locate well correctly on above Section Plat

If a producing well is abandoned, date of last production _____ 19 ____
Was permission obtained from the Conservation Division or its agents before plugging was commenced? Yes

Name of Conservation Agent who supervised plugging of this well Eldon Petty
Producing formation _____ Depth to top _____ Bottom _____ Total Depth of Well _____ Feet
Show depth and thickness of all water, oil and gas formations.

OIL, GAS OR WATER RECORDS

CASING RECORD

FORMATION	CONTENT	FROM	TO	SIZE	PUT IN	PULLED OUT
				8-5/8"	329.05	none

Describe in detail the manner in which the well was plugged, indicating where the mud fluid was placed and the method or methods used in introducing it into the hole. If cement or other plugs were used, state the character of same and depth placed, from _____ feet to _____ feet for each plug set.

Filled hole with heavy mud to 300'. Set Plug.
Put in 1/2 sack hulls and 15 sacks of cement.
Filled with heavy mud to 40'. Set Plug.
Filled to top with 1/2 sack hulls and 10 sacks cement.

(If additional description is necessary, use BACK of this sheet)

Name of Plugging Contractor C-G Drilling Co.
Address 107 Rule Bldg., Wichita, Kansas



STATE OF KANSAS, COUNTY OF SEDGWICK, ss.
JAY H. GALLOWAY (employee of owner) or (owner or operator) of the above-described well, being first duly sworn on oath, says: That I have knowledge of the facts, statements, and matters herein contained and the log of the above-described well as filed and that the same are true and correct. So help me God.

(Signature) Jay H. Galloway
107 Rule Bldg., Wichita, Kansas
(Address)

Subscribed and Sworn to before me this 21st day of June, 19 55

My commission expires May 20, 1959

Ricky Jacobs
Notary Public.

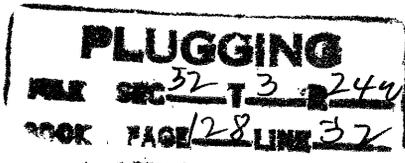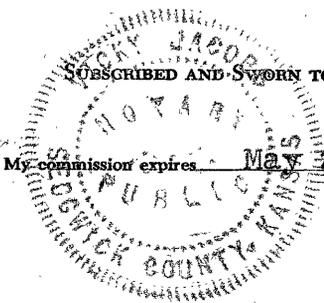

JUN 23 1955 6-23-55
CONSERVATION DIVISION
Wichita, Kansas