


15-137-00203-00-00

STATE OF KANSAS  
STATE CORPORATION COMMISSION

Give All Information Completely  
Make Required Affidavit  
Mail or Deliver Report to:  
Conservation Division  
State Corporation Commission  
800 Biting Building  
Wichita, Kansas

WELL PLUGGING RECORD

NORTH

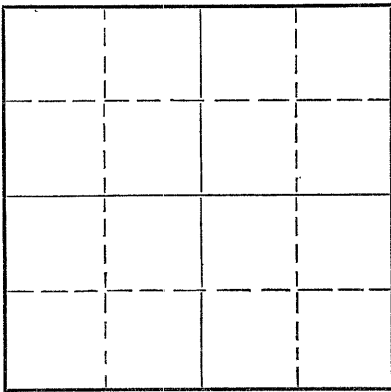

Locate well correctly on above  
Section Plat

Norton County. Sec. 26 Twp. 3 Rge. 24 (E) (W)  
Location as "NE/CNW&SW" or footage from lines SE SE NW  
Lease Owner Sauvage & Dunn Drilling Co., Inc.  
Lease Name Porter Well No. 1  
Office Address Oberlin, Kansas  
Character of Well (completed as Oil, Gas or Dry Hole) Dry Hole  
Date well completed November 25, 1955 1955  
Application for plugging filed November 25, 1955  
Application for plugging approved November 25, 1955  
Plugging commenced November 26, 1955  
Plugging completed November 26 1955  
Reason for abandonment of well or producing formation dry

If a producing well is abandoned, date of last production \_\_\_\_\_ 19\_\_\_\_  
Was permission obtained from the Conservation Division or its agents before plugging was commenced? yes

Name of Conservation Agent who supervised plugging of this well Elden Petty  
Producing formation \_\_\_\_\_ Depth to top \_\_\_\_\_ Bottom \_\_\_\_\_ Total Depth of Well 3792 Feet  
Show depth and thickness of all water, oil and gas formations.

OIL, GAS OR WATER RECORDS

CASING RECORD

FORMATION	CONTENT	FROM	TO	SIZE	PUT IN	PULLED OUT

Describe in detail the manner in which the well was plugged, indicating where the mud fluid was placed and the method or methods used in introducing it into the hole. If cement or other plugs were used, state the character of same and depth placed, from \_\_\_\_\_ feet to \_\_\_\_\_ feet for each plug set.

Filled hole with heavy mud thru drill pipe, pulled pipe to 240 ft. set plug mixed with 15 sx cement 1/2 sv hulls. Filled with heavy mud to 40 feet. 2nd with 10 sx cement 1/2 sx hulls. Filled hole to bottom of cellar.

(If additional description is necessary, use BACK of this sheet)

Name of Plugging Contractor Sauvage & Dunn Drilling Co., Inc,  
Address \_\_\_\_\_

STATE OF Kansas, COUNTY OF Norton, ss.  
\_\_\_\_\_  
(employee of owner) or (owner or operator) of the above-described well, being first duly sworn on oath, says: That I have knowledge of the facts, statements, and matters herein contained and the log of the above-described well as filed and that the same are true and correct. So help me God.

(Signature) W W Sauvage  
Oberlin Kansas  
(Address)

SUBSCRIBED AND SWORN TO before me this 29<sup>th</sup> day of November, 1955

My commission expires May 17, 1959  
Opal Sauvage Notary Public.

24-7368-S 3-53-20M

PLUGGING  
FILE DEC 26 T 3 P 4 W  
BOOK PAGE 19 LINE 42

11-30-55