


Give All Information Completely
Make Required Affidavit
Mail or Deliver Report to:
Conservation Division
State Corporation Commission
211 No. Broadway
Wichita, Kansas

WELL PLUGGING RECORD

15-137-00247-00-00

NORTH

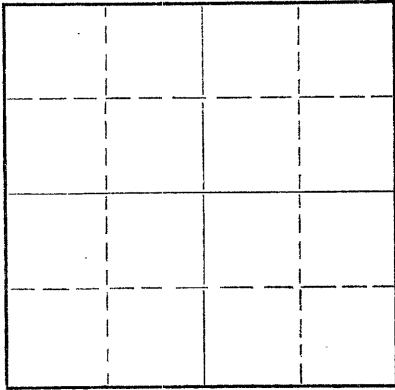

Locate well correctly on above
Section Plat

Norton

County. Sec. 10 Twp. 3 Rge. (E) 23 (W)

Location as "NE/CNW/SW" or footage from lines. NW NW SE

Lease Owner Brooks Hall

Lease Name HORESKY Well No. 1

Office Address 200 South Harvey-Oklahoma City, Oklahoma

Character of Well (completed as Oil, Gas or Dry Hole) Dry

Date well completed 8-28 19 56

Application for plugging filed 8-28 19 56

Application for plugging approved 8-28 19 56

Plugging commenced 8-28 19 56

Plugging completed 8-28 19 56

Reason for abandonment of well or producing formation Dry

If a producing well is abandoned, date of last production 19

Was permission obtained from the Conservation Division or its agents before plugging was commenced? Yes

Name of Conservation Agent who supervised plugging of this well Eldon Petty

Producing formation Depth to top Bottom Total Depth of Well 3682 Feet

Show depth and thickness of all water, oil and gas formations.

OIL, GAS OR WATER RECORDS

CASING RECORD

FORMATION	CONTENT	FROM	TO	SIZE	PUT IN	PULLED OUT
				8-5/8	170	None

Describe in detail the manner in which the well was plugged, indicating where the mud fluid was placed and the method or methods used in introducing it into the hole. If cement or other plugs were used, state the character of same and depth placed, from feet to feet for each plug set.

- Filled hole with heavy mud
- Pushed plug to 160
- Dumped 1/2 sack hulls on top of plug
- Mixed 15 sacks cement and dumped on top of hulls
- Filled hole to top
- Pushed plug to 40
- Dumped in 1/2 sack hulls
- Mixed 10 sacks cement and filled hole to top with same.

(If additional description is necessary, use BACK of this sheet)

Name of Plugging Contractor Jones, Shelburne & Farmer, Inc.

Address Russell, Kansas

STATE OF Kansas, COUNTY OF Russell, ss.
JOHN O. FARMER

(employee of owner) or (owner or operator) of the above-described well, being first duly sworn on oath, says: That I have knowledge of the facts, statements, and matters herein contained and the log of the above-described well as filed and that the same are true and correct. So help me God.

(Signature)

John O. Farmer
Russell, Kansas
(Address)

SUBSCRIBED AND SWORN TO before me this 31st day of August, 19 56

My commission expires 10-11-58

STATE CORPORATION COMMISSION

Notary Public.

PLUGGING
FILE SEC 10 T 3 R 23W
BOOK PAGE 95 LINE 2

SEP 5 1956
09-05-1956
CONSERVATION DIVISION
Wichita, Kansas