


WELL PLUGGING RECORD

Give All Information Completely  
Make Required Affidavit  
Mail or Deliver Report to:  
Conservation Division  
State Corporation Commission  
211 No. Broadway  
Wichita, Kansas

NORTH

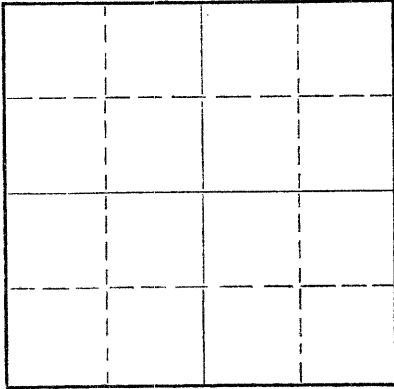

Locate well correctly on above  
Section Plat

Norton County. Sec. 10 Twp 3S Rge 23W (E) (W)  
Location as "NE/CNW/SW" or footage from lines SW SW NW  
Lease Owner Burch Drilling Co., Inc.  
Lease Name Henderson Well No. 1  
Office Address 1011 Union Center, Wichita, Kansas  
Character of Well (completed as Oil, Gas or Dry Hole) Dry Hole  
Date well completed November 3, 1959 19  
Application for plugging filed November 3, 1959 19  
Application for plugging approved November 3, 1959 19  
Plugging commenced November 3, 1959 19  
Plugging completed November 3, 1959 19  
Reason for abandonment of well or producing formation Dry Hole

If a producing well is abandoned, date of last production \_\_\_\_\_ 19  
Was permission obtained from the Conservation Division or its agents before plugging was commenced? yes

Name of Conservation Agent who supervised plugging of this well A. L. Fabricus  
Producing formation \_\_\_\_\_ Depth to top \_\_\_\_\_ Bottom \_\_\_\_\_ Total Depth of Well 3600 Feet  
Show depth and thickness of all water, oil and gas formations.

OIL, GAS OR WATER RECORDS

CASING RECORD

FORMATION	CONTENT	FROM	TO	SIZE	PUT IN	PULLED OUT

Describe in detail the manner in which the well was plugged, indicating where the mud fluid was placed and the method or methods used in introducing it into the hole. If cement or other plugs were used, state the character of same and depth placed, from \_\_\_\_\_ feet to \_\_\_\_\_ feet for each plug set.

1st plug set at 500 feet with 20 (twenty) sacks of cement.  
2nd plug set at 190' with 20 (twenty) sacks of cement.  
3rd plug set at 40' with 10 (ten) sacks of cement.

RECEIVED  
STATE CORPORATION COMMISSION  
NOV 13 1959  
11-13-1959  
CONSERVATION DIVISION  
Wichita, Kansas

(If additional description is necessary, use BACK of this sheet)  
Name of Plugging Contractor Burch Drilling Co., Inc.  
Address 1011 Union Center, Wichita, Kansas

STATE OF KANSAS, COUNTY OF SEDGWICK, ss.  
Earl M. Burch, President (employee of owner) or (owner or operator) of the above-described well, being first duly sworn on oath, says: That I have knowledge of the facts, statements, and matters herein contained and the log of the above-described well as filed and that the same are true and correct. So help me God.

(Signature) Earl M. Burch  
Earl M. Burch, President  
(Address)

SUBSCRIBED AND SWORN TO before me this 6th day of November, 1959.

My commission expires March 12, 1963.  
Shirley Ann Arn  
Shirley Ann Arn  
Notary Public.

