


Give All Information Completely
Make Required Affidavit
Mail or Deliver Report to:
Conservation Division
State Corporation Commission
800 Biting Building
Wichita, Kansas

15-137-00108-00-00
WELL PLUGGING RECORD

Norton County. Sec. 9 Twp. 3 Rge. 23 (E) W (W)

Location as "NE/CNW/SW" or footage from lines NE NE NW
Lease Owner Harry Gore
Lease Name Snyder Well No. 1
Office Address 400 Brown Bldg., Wichita 2, Kansas
Character of Well (completed as Oil, Gas or Dry Hole) Dry Hole
Date well completed 10-24- 19 53
Application for plugging filed 10-24- 19 53
Application for plugging approved 10-24- 19 53
Plugging commenced 10-24- 19 53
Plugging completed 10-24- 19 53
Reason for abandonment of well or producing formation Dry Hole

If a producing well is abandoned, date of last production _____ 19____
Was permission obtained from the Conservation Division or its agents before plugging was commenced? yes

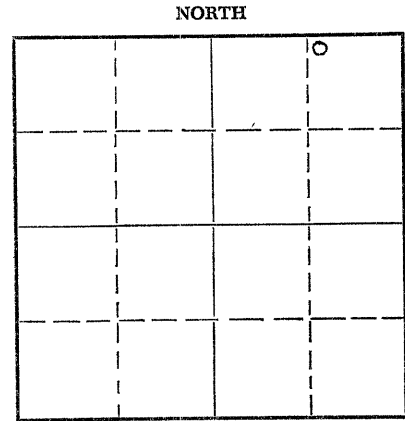

Locate well correctly on above Section Plat

Name of Conservation Agent who supervised plugging of this well Eldon Petty
Producing formation _____ Depth to top _____ Bottom _____ Total Depth of Well 3575 Feet
Show depth and thickness of all water, oil and gas formations.

OIL, GAS OR WATER RECORDS

CASING RECORD

FORMATION	CONTENT	FROM	TO	SIZE	PUT IN	PULLED OUT
Surface	Pipe	0	214'	8-5/8"	214'	0

Describe in detail the manner in which the well was plugged, indicating where the mud fluid was placed and the method or methods used in introducing it into the hole. If cement or other plugs were used, state the character of same and depth placed, from _____ feet to _____ feet for each plug set.

Set first plug at 195', 15 sacks of cement.
Set second plug at 4', 10 sacks of cement.

RECEIVED
STATE CORPORATION COMMISSION
OCT 29 1953
10-29-1953
CONSERVATION DIVISION
Wichita, Kansas

(If additional description is necessary, use BACK of this sheet)
Name of Plugging Contractor Empire Drilling Company
Address 1121 Union Nat'l. Bk. Bldg., Wichita 2, Kansas

STATE OF KANSAS, COUNTY OF SEDGWICK, ss.
I, Dan J. Kornfeld - contractor ~~representative of the above-described well~~ of the above-described well, being first duly sworn on oath, says: That I have knowledge of the facts, statements, and matters herein contained and the log of the above-described well as filed and that the same are true and correct. So help me God.

(Signature) Dan J. Kornfeld
1121 Union Nat'l. Bk. Bldg., Wichita 2, Kansas
(Address)

SUBSCRIBED AND SWORN TO before me this 24 day of October, 19 53

My commission expires May 5, 1956
Mary Steinmeier Notary Public.

PLUGGING
FILE SEC 9-13-230
BOOK PAGE 139 LINE 7