


WELL PLUGGING RECORD

Give All Information Completely
Make Required Affidavit
Mail or Deliver Report to:
Conservation Division
State Corporation Commission
211 No. Broadway
Wichita, Kansas

Norton County, Sec. 5 Twp. 3S Rge. 23W (E) (W)
C E/2 NE NE

Location as "NE/CNW/SW" or footage from lines _____
Lease Owner Allen Oldham
Lease Name Fedde Well No. 1
Office Address Marion, Kansas
Character of Well (completed as Oil, Gas or Dry Hole) D & A
Date well completed February 4, 1964 19 64
Application for plugging filed Feb. 6 19 64
Application for plugging approved _____ 19 _____
Plugging commenced February 4, 19 64
Plugging completed February 4, 19 64
Reason for abandonment of well or producing formation Dry

If a producing well is abandoned, date of last production _____ 19 _____
Was permission obtained from the Conservation Division or its agents before plugging was commenced? Yes

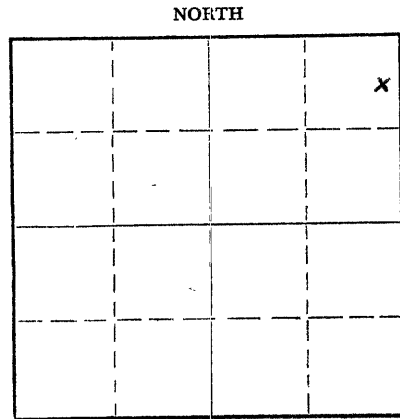

Locate well correctly on above Section Plat

Name of Conservation Agent who supervised plugging of this well W. L. Nichols, Moreland, Kansas
Producing formation _____ Depth to top _____ Bottom _____ Total Depth of Well 3657 Feet
Show depth and thickness of all water, oil and gas formations.

OIL, GAS OR WATER RECORDS

CASING RECORD

FORMATION	CONTENT	FROM	TO	SIZE	PUT IN	PULLED OUT

Describe in detail the manner in which the well was plugged, indicating where the mud fluid was placed and the method or methods used in introducing it into the hole. If cement or other plugs were used, state the character of same and depth placed, from _____ feet to _____ feet for each plug set.

1st plug set @ 540' w/20sx. cement
2nd plug set @ 240' w/50 sx. cement
3rd plug set @ 30' w/30 sx. cement

RECEIVED
STATE CORPORATION COMMISSION

FEB 10 1964
02-10-1964
CONSERVATION DIVISION
Wichita, Kansas

(If additional description is necessary, use BACK of this sheet)

Name of Plugging Contractor National Drilling Company, Inc.
Address 531 Petroleum Bldg., Wichita, Kansas

STATE OF KANSAS, COUNTY OF SEDGWICK, ss.
Glen N. Rupe (employee of owner) or (owner or operator) of the above-described well, being first duly sworn on oath, says: That I have knowledge of the facts, statements, and matters herein contained and the log of the above-described well as filed and that the same are true and correct. So help me God.

(Signature) Glen N. Rupe
531 Petro. Bldg.
(Address)

SUBSCRIBED AND SWORN TO before me this 6th day of February, 19 64
Alice M. Taylor
Notary Public.

My commission expires February 24, 1964

