


15-137-20191-00-00

STATE OF KANSAS  
STATE CORPORATION COMMISSION

WELL PLUGGING RECORD

Give All Information Completely  
Make Required Affidavit  
Mail or Deliver Report to  
Conservation Division  
State Corporation Comm.  
245 North Water  
Wichita, KS 67202

Norton County, Sec. 4 Twp. 3S Rge. 23 E/W  
Location as "NE/CNW1SW1" or footage from lines  
400' W & 400' N of NE SE  
Lease Owner Baird Oil Company, Inc.  
Lease Name DIRK Well No. 1  
Office Address Box 7, Logan, Kansas 67646  
Character of Well (Completed as Oil, Gas or Dry Hole)  
Dry Hole

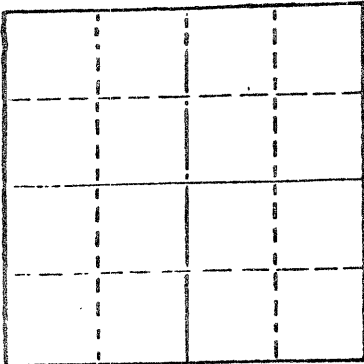

Locate well correctly on above  
Section Plat

Date Well completed 10-01-80  
Application for plugging filed 10-01-80  
Application for plugging approved 10-01-80  
Plugging commenced 10-01-80  
Plugging completed 10-01-80  
Reason for abandonment of well or producing formation  
No commercial quantity of oil or gas available  
If a producing well is abandoned, date of last production  
19

Was permission obtained from the Conservation Division or  
its agents before plugging was commenced? Yes

Name of Conservation Agent who supervised plugging of this well Gilbert Balthazar  
Producing formation \_\_\_\_\_ Depth to top \_\_\_\_\_ Bottom \_\_\_\_\_ Total Depth of Well 3563'  
Show depth and thickness of all water, oil and gas formations.

OIL, GAS OR WATER RECORDS

CASING RECORD

FORMATION	CONTENT	FROM	TO	SIZE	PUT IN	PULLED OUT

Describe in detail the manner in which the well was plugged, indicating where the mud fluid  
was placed and the method or methods used in introducing it into the hold. If cement or other  
plugs were used, state the character of same and depth placed, from \_\_\_\_\_ feet to  
\_\_\_\_\_ feet for each plug set.

T.D. 3563' LTD 3560'  
Set 1st plug @ 850' with 60 sx.  
2nd plug @ 200' with 30 sx.  
3rd plug @ 40' solid bridge with 10 sx.  
Rathole with 5 sx., 50/50 posmix, 6% gel.

Plug was down @ 7:30 p.m. 10-01-80.

RECEIVED  
STATE CORPORATION COMMISSION  
10-14-1980  
OCT 14 1980

CONSERVATION DIVISION  
Wichita, Kansas

(If additional description is necessary, use BACK of this sheet)

Name of Plugging Contractor Abercrombie Drilling, Inc.

STATE OF Kansas COUNTY OF Sedgwick, ss.  
Jack L. Partridge, Asst. Sec.-Treas. (employee of owner) or (owner or operator)  
of the above-described well, being first duly sworn on oath, says: That I have knowledge of  
the facts, statements, and matters herein contained and the log of the above-described well  
as filed and that the same are true and correct. So help me God.

(Signature) Jack L. Partridge  
801 Union Center, Wichita, Kansas  
(Address)

SUBSCRIBED AND SWORN TO before me this 8th day of October, 1980

Jeanette A. Metheny  
Jeanette A. Metheny Notary Public.

My commission expires 08-18-84

