

WELL PLUGGING RECORD


Give All Information Completely
Make Required Affidavit
Mail or Deliver Report to:
Conservation Division
State Corporation Commission
800 Biting Building
Wichita, Kansas

15-137-00062-00-00

FORMATION PLUGGING RECORD

Strike out upper line when reporting plugging of formations.

Norton County. Sec. 12 Twp. 3S Rge. 23 (E) W (W)
Location as "NE $\frac{1}{4}$ NW $\frac{1}{4}$ SW $\frac{1}{4}$ " or footage from lines. NW NW SW
Lease Owner Great Lakes Carbon Corp.
Lease Name L. W. Muir Well No. 1
Office Address 501 Petroleum Bldg., Wichita, Kansas
Character of Well (completed as Oil, Gas or Dry Hole) Dry Hole
Date well completed 7-3-51 19
Application for plugging filed 7-3-51 19
Application for plugging approved 7-3-51 19
Plugging commenced 8 AM 7-3-51 19
Plugging completed 5 PM 7-3-51 19
Reason for abandonment of well or producing formation Dry hole
If a producing well is abandoned, date of last production 19
Was permission obtained from the Conservation Division or its agents before plugging was commenced? Yes

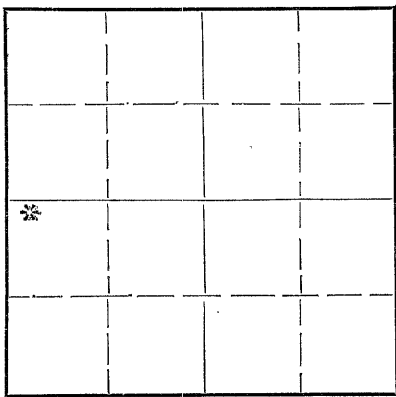

Locate well correctly on above Section Plat

Name of Conservation Agent who supervised plugging of this well Eldon Petty, Hays, Kansas
Producing formation None Depth to top. Bottom. Total Depth of Well 3722 Feet
Show depth and thickness of all water, oil and gas formations.

OIL, GAS OR WATER RECORDS

CASING RECORD

Formation	Content	From	To	Size	Put In	Pulled Out
Fresh water		75	104	8-5/8"	218	None

Describe in detail the manner in which the well was plugged, indicating where the mud fluid was placed and the method or methods used in introducing it into the hole. If cement or other plugs were used, state the character of same and depth placed, from feet to feet for each plug set.

Heavy mud 3722 to 200
Halliburton plug at 200
 $\frac{1}{2}$ sack cottonseed hulls on top
15 sacks cement 200 to 160
Heavy mud 160 to 40
Halliburton plug at 40
 $\frac{1}{2}$ sack hulls on top of plug
10 sacks cement 40 to 4'

RECEIVED
STATE CORPORATION COMMISSION
JUL 6 1951
07-06-1951
CONSERVATION DIVISION
WICHITA, KANSAS

(If additional description is necessary, use BACK of this sheet)

Correspondence regarding this well should be addressed to Great Lakes Carbon Corporation
Address 501 Petroleum Bldg., Wichita, Kansas

STATE OF KANSAS, COUNTY OF SEDGWICK, ss.
I, D. H. Sholtus, Prod. Supt. (employee of owner) or (owner or operator) of the above-described well, being first duly sworn on oath, says: That I have knowledge of the facts, statements, and matters herein contained and the log of the above-described well as filed and that the same are true and correct. So help me God.

(Signature) D. H. Sholtus

501 Petroleum Bldg., Wichita, Kansas. (Address)

SUBSCRIBED AND SWORN TO before me this 5th day of July, 1951

My commission expires January 22, 1955 Notary Public.

PLUGGING
FILE SEC 12 T 3 R 23 W
BOOK PAGE 92 LINE 24

15-137-00062-00-00

Drillers Log

Operator: Great Lakes Carbon Corporation
Contractor: Honaker Drilling Company, Incorporated
Lease: Muir #1

Top Soil and Clay	0	70
Sand	70	105
Shale	105	218
Run 7 Jts. 8 5/8" 24# New Seamless Casing (222.83 Ft.) Pipe set at 218' - Cemented with 150 Sacks Cement.		
Shale and Clay	218	580
Shale	580	680
Sand and Shale	680	910
Sand and Shale	910	1235
Sand and Shale	1235	1495
Shale-Sand-Shells	1495	1845
Shale and Shells	1845	1930
Anhydrite	1930	1965
Shale and Lime	1965	2030
Red Bed	2030	2100
Red Bed and Shale	2100	2295
Shale and Shells	2295	2325
Shale and Shells	2550	2600
Lime and Shale	2600	2780
Lime	2780	2830
Lime and Shale	2830	2935
Shale and Lime	2935	3030
Lime and Shale	3030	3115
Lime and Shale	3115	3430
Lime and Shale	3430	3615
Lime and Shale	3615	3692
Lime	3692	3704
Lime and Shale	3704	3722 T D

The above is correct to the best of my knowledge.

HONAKER DRILLING CO., INC.

By J. J. Honaker
President

Subscribed and sworn to before me this 12th day of July 1951.

My Commission Expires: June 25, 1955

Garnett S. Fischer
Notary Public
Barton County, Kansas
STATE CORPORATION COMMISSION
07-21-1951
JUL 21 1951

PLUGGING
FILE SEC 123 R3W
BOOK PAGE 98 LINE 24

CONSERVATION DIVISION
Wichita, Kansas