


Give All Information Completely
Make Required Affidavit
Mail or Deliver Report to:
Conservation Division
State Corporation Commission
212 No. Market
Wichita, Kansas

WELL PLUGGING RECORD

73
KCC-111
8-2-67

NORTH

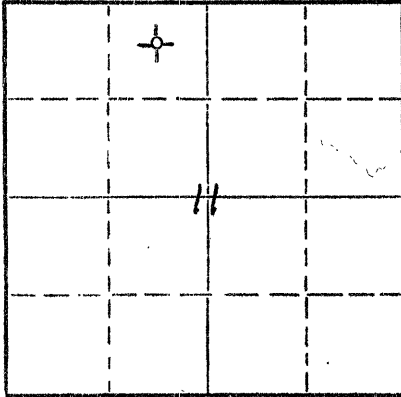

Locate well correctly on above Section Plat

Norton County, Sec. 11 Twp. 3S Rge. XXXXX 21 (W)
Location as "NE/CNWxSWx" or footage from lines NE/NW
Lease Owner Rockford Mineral Products, Inc.
Lease Name Harrison Well No. 1
Office Address 206 W. State St., Rockford, Ill.
Character of Well (completed as Oil, Gas or Dry Hole) dry hole
Date well completed 6/21/67 19
Application for plugging filed 6/23/67 19
Application for plugging approved 6/21/67 19
Plugging commenced 6/21/67 19
Plugging completed 6/21/67 19
Reason for abandonment of well or producing formation dry hole

If a producing well is abandoned, date of last production 19
Was permission obtained from the Conservation Division or its agents before plugging was commenced? yes

Name of Conservation Agent who supervised plugging of this well W. L. Nichols
Producing formation _____ Depth to top _____ Bottom _____ Total Depth of Well 3674 Feet
Show depth and thickness of all water, oil and gas formations.

OIL, GAS OR WATER RECORDS

CASING RECORD

FORMATION	CONTENT	FROM	TO	SIZE	PUT IN	PULLED OUT
clay		0	50'			
sand		50	60'			
shale and shells		60	240'	8 5/8"	240'	-0-

Describe in detail the manner in which the well was plugged, indicating where the mud fluid was placed and the method or methods used in introducing it into the hole. If cement or other plugs were used, state the character of same and depth placed, from _____ feet to _____ feet for each plug set.

Bottom plug 600' w/20 sx cement
Middle plug @ 240' w/ 1/2 sx hulls and 20 sx cement
Top plug @ 40' w/1/2 sx hulls and 105 sx cement
rat hole plugged with 2 sx cement

RECEIVED
STATE CORPORATION COMMISSION
JUN 26 1967
06-26-1967
TITON DIVISION
WICHITA, KANSAS

(If additional description is necessary, use BACK of this sheet)

Name of Plugging Contractor Vaughan Drilling, Inc.
Address 1618 Wichita Plaza Bldg., Wichita, Kansas

STATE OF Kansas, COUNTY OF Sedgwick, ss.
Donald D. Vaughan (employee of owner) or (owner or operator) of the above-described well, being first duly sworn on oath, says: That I have knowledge of the facts, statements, and matters herein contained and the log of the above-described well as filed and that the same are true and correct. So help me, God.

(Signature) Donald D. Vaughan
1618 Wichita Plaza Bldg., Wichita, Kansas
(Address)

SUBSCRIBED AND SWORN to before me this 23rd day of June, 19 67.

My commission expires 3/10/71

Carolyn Sinning
Carolyn Sinning Notary Public.