


15-137-00506-00-00

STATE OF KANSAS  
STATE CORPORATION COMMISSION

WELL PLUGGING RECORD

Give All Information Completely  
Make Required Affidavit  
Mail or Deliver Report to  
Conservation Division  
State Corporation Comm.  
245 North Water  
Wichita, KS 67202

Norton County, Sec. 25 Twp. 3S Rge. 24 E/W  
Location as "NE/CNW 1/4 SW 1/4" or footage from lines  
CE1/2 W1/2 SE  
Lease Owner Koch Exploration Company  
Lease Name Fought Well No. 2  
Office Address P.O. Box 2256; Wichita, Kansas  
Character of Well (Completed as Oil, Gas or Dry Hole)  
Oil Well

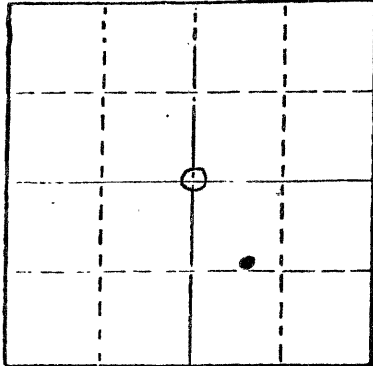

Locate well correctly on above  
Section Plat

Date Well completed February 1 1954  
Application for plugging filed August 4 1980  
Application for plugging approved August 6 1980  
Plugging commenced August 28 1980  
Plugging completed August 28 1980  
Reason for abandonment of well or producing formation  
Productive zone was depleted  
If a producing well is abandoned, date of last production  
October 1978

Was permission obtained from the Conservation Division or  
its agents before plugging was commenced? Yes

Name of Conservation Agent who supervised plugging of this well Gilbert Balthazor  
Producing formation O.H. Arb Depth to top 3753 Bottom 3762 Total Depth of Well 3762  
Show depth and thickness of all water, oil and gas formations.

OIL, GAS OR WATER RECORDS

CASING RECORD

FORMATION	CONTENT	FROM	TO	SIZE	PUT IN	PULLED OUT
				8-5/8 24#	281	None
				5-1/2 14#	3753	None

Describe in detail the manner in which the well was plugged, indicating where the mud fluid was placed and the method or methods used in introducing it into the hold. If cement or other plugs were used, state the character of same and depth placed, from \_\_\_\_\_ feet to \_\_\_\_\_ feet for each plug set. The plugging procedure used on the Fought #2 was done in accordance with the Rules and Regulation of the State Corporation Commission and supervised by Mr. Gilbert Balthazor. There were 60 sks of cmt pmpd into annulus at 150# and closed in the 100#. Hooked up to 5-1/2" casing and pmpd in 2 sx of cotton seed hulls and 70 sx of cmt at 100# pressure and closed in. Job completed.

Type of cement used was 60/40 pozmix with 6% gel mixture.

RECEIVED  
STATE CORPORATION COMMISSION  
OCT - 1 1980  
CONSERVATION DIVISION  
Wichita, Kansas

(If additional description is necessary, use BACK of this sheet)

Name of Plugging Contractor Halliburton

STATE OF KANSAS COUNTY OF SEDGWICK, ss. 10-1-80  
I Vernon J. Lowe employee of Koch Exploration (employee of owner) or (owner or operator) of the above-described well, being first duly sworn on oath, says: That I have knowledge of the facts, statements, and matters herein contained and the log of the above-described well as filed and that the same are true and correct. So help me God.

(Signature) Vernon J. Lowe  
P. O. Box 2256, Wichita, KS 67201  
(Address)

SUBSCRIBED AND SWORN TO before me this 29th day of September, 1980

CINDY L. MADSON  
Sedgwick County, Ks.  
My Appt. Exp. 2-10-81

Cindy L. Madson  
Notary Public.

My commission expires \_\_\_\_\_