

Give All Information Completely
Make Required Affidavit
Mail or Deliver Report to:
Conservation Division
State Corporation Commission
212 No. Market
Wichita, Kansas

WELL PLUGGING RECORD

Decatur County. Sec. 5 Twp. 3S Rge. 26W (E) (W)

Location as "NE/CNW/SW" or footage from lines C NW SE
Lease Owner Raymond Oil Company

Lease Name Hix Well No. 1

Office Address 410 Fourth National Bank Bldg., Wichita, Kansas 67202

Character of Well (completed as Oil, Gas or Dry Hole) D&A

Date well completed 2/21/69

Application for plugging filed 2/21/69


Application for plugging approved 2/21/69

Plugging commenced 2/21/69

Plugging completed 2/21/69

Reason for abandonment of well or producing formation D&A

If a producing well is abandoned, date of last production 19__
Was permission obtained from the Conservation Division or its agents before plugging was commenced? yes

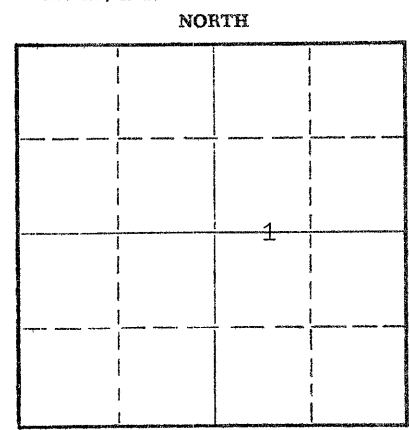

Locate well correctly on above Section Plat

Name of Conservation Agent who supervised plugging of this well
Producing formation Depth to top Bottom Total Depth of Well Feet

Show depth and thickness of all water, oil and gas formations.

OIL, GAS OR WATER RECORDS

CASING RECORD

FORMATION	CONTENT	FROM	TO	SIZE	PUT IN	PULLED OUT

Describe in detail the manner in which the well was plugged, indicating where the mud fluid was placed and the method or methods used in introducing it into the hole. If cement or other plugs were used, state the character of same and depth placed, from feet to feet for each plug set.

1st plug set @ 1450 w/100 sxs.
2nd plug set @ 275 w/ 20 sxs.
3rd plug set @ 40 w/ 10 Sxs.

RECEIVED
STATE CORPORATION COMMISSION
MAR 18 1969
CONSERVATION DIVISION
Wichita, Kansas

3-18-69

(If additional description is necessary, use BACK of this sheet)
Name of Plugging Contractor Murfin Drilling Company
Address 617 Union Center Bldg., Wichita, Kansas 67202

STATE OF Kansas, COUNTY OF Sedgwick, ss. James R. Daniels

(employee of owner) or (owner or operator) of the above-described well, being first duly sworn on oath, says: That I have knowledge of the facts, statements, and matters herein contained and the log of the above-described well as filed and that the same are true and correct. So help me God.

(Signature) James R Daniels

(Address)

Subscribed and Sworn to before me this 17th day of March, 1969

Sandra S. Holzman, Notary Public
My commission expires March 4, 1972

Sandra S. Holzman
Notary Public.

