

STATE OF KANSAS
STATE CORPORATION COMMISSION


Give All Information Completely
Make Required Affidavit
Mail or Deliver Report to:
Conservation Division
State Corporation Commission
212 No. Market
Wichita, Kansas

WELL PLUGGING RECORD

Decatur County, Sec. 9 Twp. 3 Rge. 26 ~~EX~~ (W)

Location as "NE/CNW/SW" or footage from lines E/2 SW NW
Lease Owner Weilert Enterprises
Lease Name Arnold-Weilert Well No. 1
Office Address Box 652 Hays, Ks. 67601
Character of Well (completed as Oil, Gas or Dry Hole) Dry Hole
Date well completed 1-11 19 84
Application for plugging filed 1-11 19 84
Application for plugging approved 1-11 19 84
Plugging commenced 1-11 19 84
Plugging completed 1-11 19 84
Reason for abandonment of well or producing formation Dry Hole

NORTH

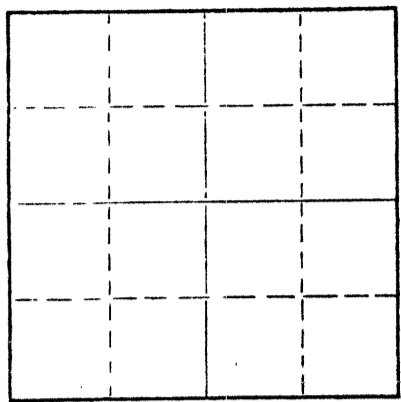

Locate well correctly on above
Section Plat

If a producing well is abandoned, date of last production 19
Was permission obtained from the Conservation Division or its agents before plugging was commenced? Yes

Name of Conservation Agent who supervised plugging of this well Carl Goodrow
Producing formation _____ Depth to top _____ Bottom _____ Total Depth of Well 3900 Feet
Show depth and thickness of all water, oil and gas formations.

OIL, GAS OR WATER RECORDS

CASING RECORD

FORMATION	CONTENT	FROM	TO	SIZE	PUT IN	PULLED OUT
Surface		0	252	8 5/8"	252	0

Describe in detail the manner in which the well was plugged, indicating where the mud fluid was placed and the method or methods used in introducing it into the hole. If cement or other plugs were used, state the character of same and depth placed, from _____ feet to _____ feet for each plug set.

1st. Plug set at 2130' with 20 sacks common cement 50-50 Poz 6%Gel 3%Cal cl
2nd. Plug set at 1420' with 100 sacks common cement 50-50 Poz 6%Gel 3%Cal cl.
3rd. Plug set at 40' with 10 sacks common cement 50-50 Poz 6%Gel 3%Cal cl, 1 sack hulls
2 sacks flow seal and solid bridge
10 sacks in rathole


(If additional description is necessary, use BACK of this sheet)

Name of Plugging Contractor Allied Cementing
Address Russell, Ks.

STATE OF Kansas, COUNTY OF Graham, ss.
Jerry M. Helberg (employee of owner) or (owner or operator) of the above-described well, being first duly sworn on oath, says: That I have knowledge of the facts, statements, and matters herein contained and the log of the above-described well as filed and that the same are true and correct. So help me God.

(Signature) Jerry M. Helberg
Box 32 Morland, Ks. 67650
(Address)

SUBSCRIBED AND SWORN TO before me this 18 day of January 1984

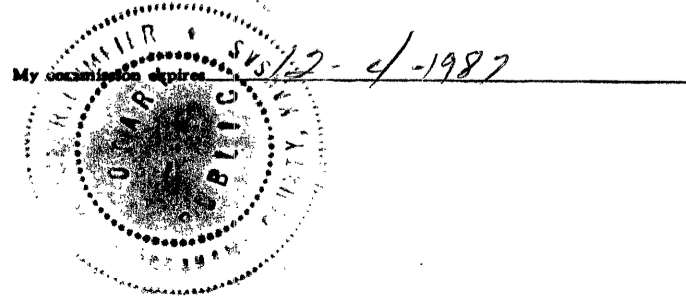

RECEIVED Notary Public
STATE CORPORATION COMMISSION

JAN 23 1984

CONSERVATION DIVISION
Wichita, Kansas
1-23-84