

13-039-20376-00-00

STATE OF KANSAS  
STATE CORPORATION COMMISSION

WELL PLUGGING RECORD

Give All Information Completely  
Make Required Affidavit  
Mail or Deliver Report to  
Conservation Division  
State Corporation Comm.  
245 North Water  
Wichita, KS 67202

Decatur County, Sec. 9 Twp. 3S Rge. 26W E/W  
Location as "NE/CNW 1/4 SW 1/4" or footage from lines  
SW NE NE


Lease Owner DuPont Oil Co.  
Lease Name ARNOLD Well No. 1

Office Address 660 Edgewater Road, Wichita, Kansas  
Character of Well (Completed as Oil, Gas or Dry Hole)  
Dry Hole

Date Well completed January 2 1977  
Application for plugging filed (Verbally) January 2 1977  
Application for plugging approved (Verb.) January 2 1977  
Plugging commenced January 2 1977  
Plugging completed January 2 1977

Reason for abandonment of well or producing formation  
No commercial quantity of oil or gas encountered  
If a producing well is abandoned, date of last production 19

Was permission obtained from the Conservation Division or its agents before plugging was commenced? Yes

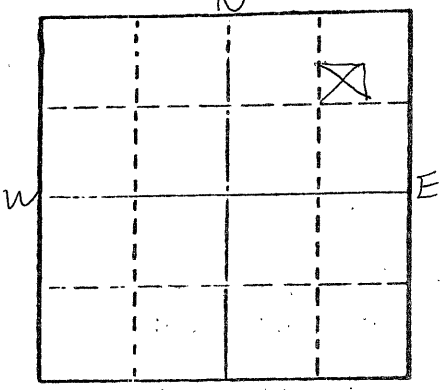

Name of Conservation Agent who supervised plugging of this well  
Producing formation Depth to top Bottom Total Depth of Well  
Show depth and thickness of all water, oil and gas formations.

OIL, GAS OR WATER RECORDS

CASING RECORD

FORMATION	CONTENT	FROM	TO	SIZE	PUT IN	PULLED OUT

Describe in detail the manner in which the well was plugged, indicating where the mud fluid was placed and the method or methods used in introducing it into the hold. If cement or other plugs were used, state the character of same and depth placed, from feet to feet for each plug set.

Set 1st plug at 1150' with 70 sx.  
2nd plug at 250' with 20 sx.  
3rd plug at 40' with 10 sx.

RECEIVED  
STATE CORPORATION COMMISSION

JAN 06 1977

Plug was down at 12:00 noon 1-02-77.

1-6-77

CONSERVATION DIVISION  
Wichita, Kansas

(If additional description is necessary, use BACK of this sheet)

Name of Plugging Contractor Abercrombie Drilling, Inc.

STATE OF Kansas COUNTY OF Sedgwick ss.

Jack L. Partridge, Asst. Sec.-Treas. (employee of owner) or (owner or operator) of the above-described well, being first duly sworn on oath, says: That I have knowledge of the facts, statements, and matters herein contained and the log of the above-described well as filed and that the same are true and correct. So help me God.

(Signature) Jack L. Partridge

801 Union Center, Wichita, Kansas 67202 (Address)

SUBSCRIBED AND SWORN TO before me this 5th day of January 19 77

My commission expires

Kathy S. Goertz  
Kathy S. Goertz Notary Public.

