

STATE CORPORATION COMMISSION OF KANSAS  
OIL & GAS CONSERVATION DIVISION  
WELL COMPLETION OR RECOMPLETION FORM  
ACO-1 WELL HISTORY  
DESCRIPTION OF WELL AND LEASE

Operator: License # 30129  
Name Eagle Creek Corporation  
Address 107 N. Market, Suite 509  
City/State/Zip Wichita, KS 67202

Purchaser N/A

Operator Contact Person William D. Harrison  
Phone (316) 264-8044

Contractor: License # 5422  
Name Abercrombie Drilling, Inc.

Wellsite Geologist Dave Callewaert  
Phone (316) 264-8044

Designate Type of Completion  
 New Well  Re-Entry  Workover  
 Oil  SWD  Temp Abd  
 Gas  Inj  Delayed Completion  
 Dry  Other (Core, Water Supply, etc.)  
If OWWO: old well info as follows:  
Operator  
Well Name  
Comp. Date  
Old Total Depth

WELL HISTORY

Drilling Method:  
 Mud Rotary  Air Rotary  Cable  
10-23-89 10-28-89 10-28-89  
Spud Date Date Reached TD Completion Date  
3750'  
Total Depth PBDT  
Amount of Surface Pipe Set and Cemented at 281.25' feet  
Multiple Stage Cementing Collar Used? Yes  No  
If yes, show depth set...feet  
If alternate 2 completion, cement circulated from...feet depth to...w/...SX cmt  
Cement Company Name  
Invoice #

API NO. 15-039-20-857-0000 FROM CONFIDENTIAL

County Decatur  
NE SE NW 8 3S 26 East  
Sec. Twp. Rge.  West

3630 Ft North from Southeast Corner of Section  
2970 Ft West from Southeast Corner of Section  
(Note: Locate well in section plat below)


Lease Name Hix Well # 1

Field Name Lippleman Northwest

Producing Formation None

Elevation: Ground 2566' KB 2571'

Section Plat

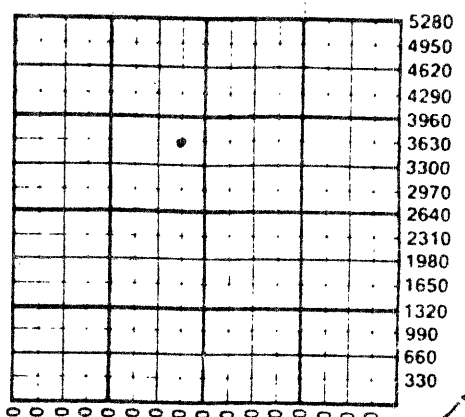

11-17-89  
RECEIVED  
STATE CORPORATION COMMISSION  
NOV 17 1990  
OIL & GAS CONSERVATION DIVISION  
WICHITA BRANCH  
KANSAS  
NOV 13

WATER SUPPLY INFORMATION

Disposition of Produced Water:  Disposal  
Docket #  Repressuring

Questions on this portion of the ACO-1 call:

Water Resources Board (913) 296-3717  
Source of Water:  
Division of Water Resources Permit #  
 Groundwater.....Ft North from Southeast Corner (Well) .....Ft West from Southeast Corner of Sec Twp Rge East West  
 Surface Water.....Ft North from Southeast Corner (Stream, pond etc).....Ft West from Southeast Corner Sec Twp Rge East West  
 Other (explain) City of Jennings  
(purchased from city, R.W.D. #)

INSTRUCTIONS: This form shall be completed in triplicate and filed with the Kansas Corporation Commission, 200 Colorado Derby Building, Wichita, Kansas 67202, within 120 days of the spud date of any well. Rule 82-3-130, 82-3-107 and 82-3-106 apply. Information on side two of this form will be held confidential for a period of 12 months if requested in writing and submitted with the form. See rule 82-3-107 for confidentiality in excess of 12 months. One copy of all wireline logs and drillers time log shall be attached with this form. Submit CP-4 form with all plugged wells. Submit CP-111 form with all temporarily abandoned wells.

All requirements of the statutes, rules and regulations promulgated to regulate the oil and gas industry have been fully complied with and the statements herein are complete and correct to the best of my knowledge.

Signature William D. Harrison

Title President Date 11/15/89

Subscribed and sworn to before me this 15 day of November 1989

Notary Public Dave Callewaert

Date Commission Expires 6/27/93

K.C.C. OFFICE USE ONLY  
F  Letter of Confidentiality Attached  
C  Wireline Log Received  
C  Drillers Timelog Received  
Distribution  
 KCC  SWD/Rep  NGPA  
 KGS  Plug  Other  
(Specify)

NOTARY PUBLIC - State of Kansas  
DAVID L. CALLEWAERT  
My Appt. Exp. 6/27/93

SIDE TWO

Operator Name Eagle Creek Corporation Lease Name Hix Well # 1

Sec. 8 Twp. 3S Rge. 26  East  West County Decatur **RELEASED**

JAN 18 1991

WELL LOG

INSTRUCTIONS: Show important tops and base of formations penetrated. Detail all cores. Report all drill stem tests giving interval tested, time tool open and closed, flowing and shut-in pressures, whether shut-in pressure reached static level, hydrostatic pressures, bottom hole temperature, fluid recovery, and flow rates if gas to surface during test. Attach extra sheet if more space is needed. Attach copy of log.

FROM CONFIDENTIAL

Drill Stem Tests Taken  Yes  No  
 Samples Sent to Geological Survey  Yes  No  
 Cores Taken  Yes  No  
 Formation Description  Log  Sample

DST#1 3454-4508, 30-30, 30-30, IFP weak surface blow died in 18 min., FFP no blow, recovered 5' mud with few spots of oil, psi 28-28, 28-28, ISIP 28, FSIP 28, FHP 1720, Temp. 116

Name	Top	Bottom
Anhydrite	2110	
Topeka lime	3289	
Heebner	3457	
Toronto	3489	
Lansing	3500	
Base of KC	3700	

DST#2 3510-3574, 30-45, 30-45, IFP weak surface blow building to 1" in water, FFP no blow, recovered 62' mud, psi 60-70, 81-81, ISIP 1083, Fsp 1004, FHP 1760 temp. 114.

DST#3 3591-3682, 30-45, 60-75, IFP good blow built up to bottom of bucket in 22 min., FFP good blow bottom of bucket in 10 min. and building through out test, recovered 10' oil cut muddy water, 1262' muddy water, psi 60-228, 259-404, ISIP 1071, FSIP 1031, FHP 1790, temp. 116.

CASING RECORD <input checked="" type="checkbox"/> New <input type="checkbox"/> Used							
Report all strings set-conductor, surface, intermediate, production, etc.							
Purpose of String	Size Hole Drilled	Size Casing Set (in O.D.)	Weight Lbs/Ft.	Setting Depth	Type of Cement	#Sacks Used	Type and Percent Additives
Surface	12 1/2"	8 5/8"	24#	281.25'	60/40poz	180	3% cc, 2% gel
PERFORATION RECORD <input checked="" type="checkbox"/> N/A				Acid, Fracture, Shot, Cement Squeeze Record			
Shots Per Foot	Specify Footage of Each Interval Perforated			(Amount and Kind of Material Used)		Depth	
N/a				N/A			
TUBING RECORD				Liner Run <input type="checkbox"/> Yes <input checked="" type="checkbox"/> No			
Date of First Production		Producing Method					
N/a		N/A <input type="checkbox"/> Flowing <input type="checkbox"/> Pumping <input type="checkbox"/> Gas Lift <input type="checkbox"/> Other (explain)					
Estimated Production Per 24 Hours		Oil	Gas	Water	Gas-Oil Ratio	Gravity	
D&A		Bbls	MCF	Bbls	CFPB		

METHOD OF COMPLETION D&A Production Interval

Disposition of gas:  Vented  Open Hole  Perforation  
 Sold  Other (Specify) .....  
 Used on Lease

Dually Completed  
 Commingled

