


15-153-05133-00-00

Give All Information Completely
Make Required Affidavit
Mail or Deliver Report to:
Conservation Division
State Corporation Commission
211 No. Broadway
Wichita, Kansas

WELL PLUGGING RECORD

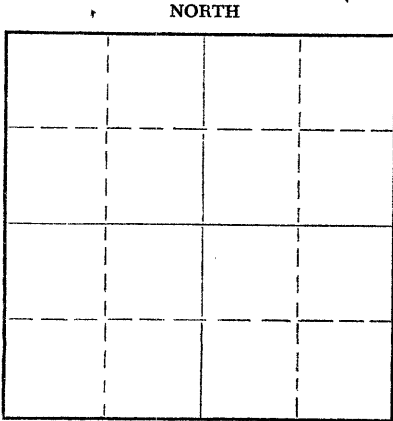

Locate well correctly on above Section Plat

Rawlins County. Sec. 7 Twp. 2S Rge. 36 (E) (W)
Location as "NE/CNW/SW" or footage from lines C SW 1/4 NW 1/4 SE 1/4
Lease Owner Miami Petroleum Company, Inc.
Lease Name Fred Brumm "A" Well No. 2
Office Address P.O. Drawer 2040, Abilene, Texas
Character of Well (completed as Oil, Gas or Dry Hole) Dry Hole
Date well completed June 3, 1959
Application for plugging filed June 3, 1959
Application for plugging approved June 26, 1959 (written approval)
Plugging commenced June 3, 1959
Plugging completed June 3, 1959
Reason for abandonment of well or producing formation Non-productive of oil or gas
If a producing well is abandoned, date of last production
Was permission obtained from the Conservation Division or its agents before plugging was commenced? Yes - verbal & written

Name of Conservation Agent who supervised plugging of this well A. D. Fabricius, Box 731, Hill City, Kansas
Producing formation Depth to top Bottom Total Depth of Well 5110 Feet
Show depth and thickness of all water, oil and gas formations.

OIL, GAS OR WATER RECORDS

CASING RECORD

FORMATION	CONTENT	FROM	TO	SIZE	PUT IN	PULLED OUT
Top of Topeka	4230'			8-5/8"	343'	None-cemented
Top of Lansing-KC	4375'					with 265 sx
Top of Marmaton	4710'					
Top of Cherokee	4845'					

Describe in detail the manner in which the well was plugged, indicating where the mud fluid was placed and the method or methods used in introducing it into the hole. If cement or other plugs were used, state the character of same and depth placed, from feet to feet for each plug set.

First plug set at 600' with 20 sacks cement
Second plug set at 340' with 20 sacks cement
Third plug set at 40' with 10 sacks cement

RECEIVED
STATE CORPORATION COMMISSION
JUL 1 1959
CONSERVATION DIVISION
Wichita, Kansas

6-1-59

(If additional description is necessary, use BACK of this sheet)
Name of Plugging Contractor Miami Petroleum Company, Inc.
Address P. O. Drwr 2040, Abilene, Texas

STATE OF Texas, COUNTY OF Taylor, ss.
Jack Stivers (employee of owner) of the above-described well, being first duly sworn on oath, says: That I have knowledge of the facts, statements, and matters herein contained and the log of the above-described well as filed and that the same are true and correct. So help me God.
(Signature) Jack Stivers
P. O. Drawer 2040, Abilene, Texas (Address)

SUBSCRIBED AND SWORN TO before me this 29th day of June, 1959
My commission expires June 1, 1961
Marilyn D. Lullery Taylor County, Texas Notary Public.

PLUGGING
FILE SEC 7 T 2 R 36W
BOOK PAGE 46 LINE 43