

15-137-00690-00-00

STATE OF KANSAS
STATE CORPORATION COMMISSION
200 Colorado Derby Building
Wichita, Kansas 67202

WELL PLUGGING RECORD
K.A.R.-82-3-117

Drilling Completed
March, 1954

API NUMBER _____
LEASE NAME Lawson "A"

TYPE OR PRINT
NOTICE: Fill out completely
and return to Cons. Div.
office within 30 days.

WELL NUMBER #7
3960 Ft. from S Section Line
3960 Ft. from E Section Line

LEASE OPERATOR John O. Farmer, Inc.

SEC. 36 TWP. 3S RGE. 24 (XXX) (W)

ADDRESS P.O. Box 352, Russell, KS 67665

COUNTY Norton

PHONE#(913) 483-3144 OPERATORS LICENSE NO. 5135

Date Well Completed 3-23-54

Character of Well Oil

Plugging Commenced 10:30 A.M.
5-12-88

(Oil, Gas, D&A, SWD, Input, Water Supply Well)

Plugging Completed 11:45 A.M.
5-12-88

The plugging proposal was approved on May 7, 1988 (date)

by Dennis Hamel (KCC District Agent's Name).

is AC0-1 filed? No If not, is well log attached? Yes

Producing Formation Arbuckle Depth to Top 3742' Bottom 3750' T.D. 3750'

Show depth and thickness of all water, oil and gas formations.

OIL, GAS OR WATER RECORDS

CASING RECORD

Formation	Content	From	To	Size	Put In	Pulled out
Arbuckle	Oil	3742'	50'	8-5/8"	280'	-0-
				5-1/2"	3742'	-0-

Describe in detail the manner in which the well was plugged, indicating where the mud fluid was placed and the method or methods used in introducing it into the hole. If cement or other plugs were used, state the character of same and depth placed, from feet to feet each set.
Down the 5-1/2" casing - mixed 25 sks. cement, then mixed 6 sks. hulls w/150 sks. cement - maximum pressure, 300%. Shut in @ 200%. Down the 8-5/8" casing - mixed 75 sks. cement. Maximum pressure - 400% and shut in @ 200%.
(if additional description is necessary, use BACK of this form.)

Name of Plugging Contractor John O. Farmer, Inc. License No. 5135

Address P.O. Box 352, Russell, KS 67665

STATE OF Kansas COUNTY OF Russell, ss.

John O. Farmer III (Operator) of above-described well, being first duly sworn on oath, says: That I have knowledge of the facts, statements, and matters herein contained and the log of the above-described well, as filed that the same are true and correct before me, God.

RECEIVED
5-27-88
MAY 27 1988


(Signature) John O. Farmer III

(Address) P.O. Box 352, Russell, KS 67665

SUBSCRIBED AND SWORN TO before me this 26th day of May, 19 88
CONSERVATION DIVISION
Wichita, Kansas

Margaret A. Schulte
Notary Public

My Commission Expires:

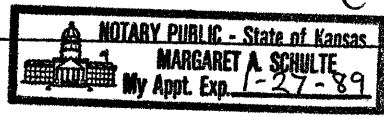

Margaret A. Schulte

Give detailed description and thickness of all formations drilled through, contents of sand, whether dry, water, oil or gas.

ADDRESS Russell, Kansas

640 Acres N

COUNTY Norton SEC 36 TWP 3 RGE 24

COMPANY OPERATING Jones, Shelburne & Farmer, Inc.

OFFICE ADDRESS Russell, Kansas

FARM NAME Lawson WELL NO 7

DRILLING STARTED 3-17, 1954 DRILLING FINISHED 3-23, 1954


DATE OF FIRST PRODUCTION COMPLETED

WELL LOCATED 1/4 NW 1/4 1/4 North of South

Line and ft. East of West Line of Quarter Section

Elevation (Relative to sea level) DERRICK FLOOR 2433 GROUND

CHARACTER OF WELL (Oil, gas or dryhole) Oil

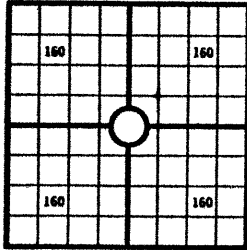

Locate well correctly

OIL OR GAS SANDS OR ZONES

Table with columns: Name, From, To, Name, From, To. Rows 1-3.

Perforating Record If Any

Shot Record

Table with columns: Formation, From, To, No. of Shots, Formation, From, To, Size of Shot.

CASING RECORD

Table with columns: Amount Set (Size, Wt., Thds., Make, Ft., In., Ft., In.), Amount Pulled (Size, Length), Packer Record (Depth Set, Make).

Liner Record: Amount Kind Top Bottom

CEMENTING AND MUDDING

Table with columns: Size, Amount Set (Ft., In.), Sacks Cement, Chemical (Gal., Make), Method of Cementing, Amount, Mudding Method, Results (See Note).

Note: What method was used to protect sands if outer strings were pulled?

NOTE: Were bottom hole plugs used? If so, state kind, depth set and results obtained

TOOLS USED

Rotary Tools were used from feet to Cable tools were used from feet to feet, and from feet to feet, and from feet to feet

Type Rig

INITIAL PRODUCTION TEST

Describe initial test: whether by flow through tubing or casing or by pumping

Amount of Oil Production bbls. Size of choke, if any Length of test Water

Production bbls. Gravity of oil Type of Pump if pump is used, describe

Main formation log table with columns: Formation, Top, Bottom, Formation, Top, Bottom. Includes handwritten entries for shale, sand, redbed, anhydrite, etc.

RECEIVED STATE CORPORATION COMMISSION

MAY 27 1958

CONSERVATION DIVISION Wichita, Kansas

TOPS:

Elevation 2434 R. B. Heebner 3451 Lansing 3491 Base of K. C. 3677 Arbuckle 3740 T. D. 3744

15-137-00690-00-00

I, the undersigned, being first duly sworn upon oath, state that this well record is true, correct and complete according to the records of this office and to the best of my knowledge and belief.

John D. Farmer, Vice-President Name and title of representative of company

Subscribed and sworn to before me this 29th day of March, 1954 My Commission expires April 23, 1956 Notary Public.

WELL NO. 7 COUNTY Norton SEC 36 TWP 3 RGE 24 FARM NAME LAWSON