

STATE OF KANSAS
STATE CORPORATION COMMISSION

WELL PLUGGING RECORD

Give All Information Completely
Make Required Affidavit
Mail or Deliver Report to
Conservation Division
State Corporation Comm.
245 North Water
Wichita, KS 67202

Decatur County, Sec. 30 Twp. 3S Rge. 26W E/W
Location as "NE/CNW 1/4 SW 1/4" or footage from lines
C SW NW

Lease Owner Bolyard Oil & Gas, Ltd.

Lease Name CECIL Well No. 1

Office Address Brooks Towers, Suite 20C, 1020 15th St., Wichita

Character of Well (Completed as Oil, Gas or Dry Hole)
Dry Hole

Date Well completed January 11 1977

Application for plugging filed (Verbally) January 11 1977

Application for plugging approved (Verb.) January 11 1977

Plugging commenced January 11 1977

Plugging completed January 11 1977

Reason for abandonment of well or producing formation

Dry Hole


If a producing well is abandoned, date of last production
19

Was permission obtained from the Conservation Division or
its agents before plugging was commenced? Yes

Name of Conservation Agent who supervised plugging of this well

Producing formation Depth to top Bottom Total Depth of Well

Show depth and thickness of all water, oil and gas formations.

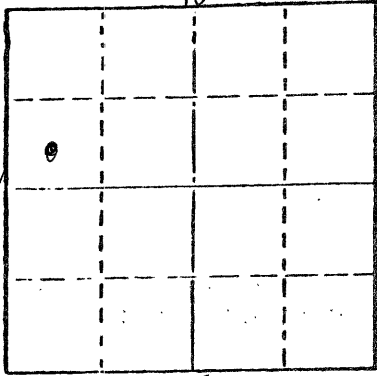

Locate well correctly on above
Section Plot

OIL, GAS OR WATER RECORDS

CASING RECORD

FORMATION	CONTENT	FROM	TO	SIZE	PUT IN	PULLED OUT

Describe in detail the manner in which the well was plugged, indicating where the mud fluid
was placed and the method or methods used in introducing it into the hold. If cement or other
plugs were used, state the character of same and depth placed, from _____ feet to
_____ feet for each plug set.

T.D. 4060'
Set 1st plug at 1200' with 70 sx.
2nd plug at 200' with 20 sx.
40' bridge with 10 sx.

Job was complete at 7:45 p.m. 1-11-77
Cement by Halliburton

(If additional description is necessary, use BACK of this sheet)

Name of Plugging Contractor Abercrombie Drilling, Inc.

STATE OF Kansas COUNTY OF Sedgwick

Jack L. Partridge, Asst. Sec.-Treas. (employee of owner) or (owner or operator) of the above-described

well, being first duly sworn on oath, says: That I have knowledge of the facts, statements, and matters herein contained and the log of the
above-described well as filed and that the same are true and correct. So help me God.

(Signature) *Jack L. Partridge*

801 Union Center, Wichita, Kansas 67202

(Address)

SUBSCRIBED AND SWORN TO before me this 14th day of January 1977

My commission expires

Kathy S. Goertz
Kathy S. Goertz Notary Public.

