


WELL PLUGGING RECORD

Give All Information Completely
Make Required Affidavit
Mail or Deliver Report to:
Conservation Division
State Corporation Commission
211 No. Broadway
Wichita, Kansas

Decatur County, Sec. 24 Twp. 3S Rge. 26 (E) (W) *

NORTH

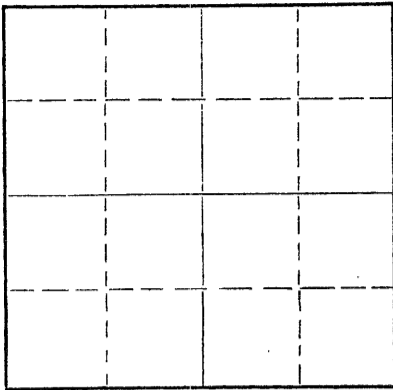

Locate well correctly on above
Section Plat

Location as "NE/CNW/SW" or footage from lines NE NE NE
Lease Owner Empire Drilling Company AND R. W. Shields
Lease Name Brooks Well No. 1
Office Address 650 Fourth National Bank Building, Wichita, Kansas
Character of Well (completed as Oil, Gas or Dry Hole) Dry Hole
Date well completed May 17, 1961 19
Application for plugging filed May 17, 1961 19
Application for plugging approved May 17, 1961 19
Plugging commenced May 17, 1961 19
Plugging completed May 17, 1961 19
Reason for abandonment of well or producing formation Dry Hole

If a producing well is abandoned, date of last production _____ 19____
Was permission obtained from the Conservation Division or its agents before plugging was commenced? yes

Name of Conservation Agent who supervised plugging of this well A. D. Fabricius
Producing formation _____ Depth to top _____ Bottom _____ Total Depth of Well 3955 Feet
Show depth and thickness of all water, oil and gas formations.

OIL, GAS OR WATER RECORDS

CASING RECORD

FORMATION	CONTENT	FROM	TO	SIZE	PUT IN	PULLED OUT
	Shale-Shells-Sand	0	975	8 5/8"	161'	-0-

Describe in detail the manner in which the well was plugged, indicating where the mud fluid was placed and the method or methods used in introducing it into the hole. If cement or other plugs were used, state the character of same and depth placed, from _____ feet to _____ feet for each plug set.

Plug set at 300' with 20 sacks cement
Plug set at 160' with 20 sacks cement
Plug set at 40' with 10 sacks cement

RECEIVED
STATE CORPORATION COMMISSION

MAY 31 1961

CONSERVATION DIVISION
Wichita, Kansas

5-31-61

(If additional description is necessary, use BACK of this sheet)

Name of Plugging Contractor Empire Drilling Company
Address 650 Fourth National Bank Building, Wichita, Kansas

STATE OF KANSAS, COUNTY OF SEDGWICK, ss.
Dan J. Kornfeld (owner or operator) of the above-described

well, being first duly sworn on oath, says: That I have knowledge of the facts, statements, and matters herein contained and the log of the above-described well as filed and that the same are true and correct. So help me God.

(Signature) [Signature]
650-4th Nat'l. Bank Bldg., Wichita, Kansas
(Address)

SUBSCRIBED AND SWORN TO before me this 25th day of May, 19 61

My commission expires October 21, 1962

Lucille H. Harr
Lucille H. Harr Notary Public.

