

STATE OF KANSAS  
STATE CORPORATION COMMISSION

WELL PLUGGING RECORD

Give All Information Completely  
Make Required Affidavit  
Mail or Deliver Report to  
Conservation Division  
State Corporation Comm.  
245 North Water  
Wichita, KS 67202

Norton County, Sec. 17 Twp. 3S Rge. 25W E/W  
Location as "NE/CNW $\frac{1}{4}$ SW $\frac{1}{4}$ " or footage from lines

SE SE NW,  
Lease Owner The National Oil Co.

Lease Name LEICHLITER Well No. 1

Office Address 200 W. Douglas, Suite 550, Wichita, Ks.

Character of Well (Completed as Oil, Gas or Dry Hole)  
Dry Hole

Date Well completed 1-19 1977

Application for plugging filed (Verbally) 1-19 1977

Application for plugging approved (Verbally) 1-19 1977

Plugging commenced 1-19 1977


Plugging completed 1-19 1977

Reason for abandonment of well or producing formation

No commercial quantity of oil or gas encountered

If a producing well is abandoned, date of last production  
19

Was permission obtained from the Conservation Division or  
its agents before plugging was commenced? Yes

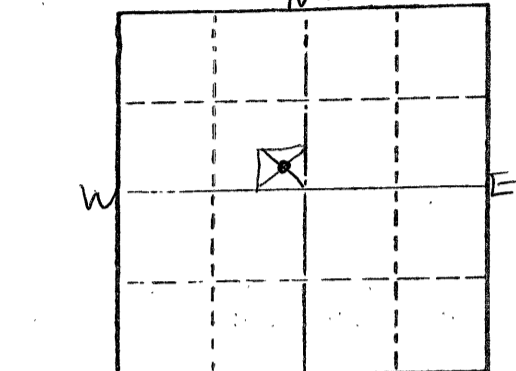

Locate well correctly on above  
Section Plat

Name of Conservation Agent who supervised plugging of this well Gilbert Balthazor

Producing formation \_\_\_\_\_ Depth to top \_\_\_\_\_ Bottom \_\_\_\_\_ Total Depth of Well \_\_\_\_\_

Show depth and thickness of all water, oil and gas formations.

OIL, GAS OR WATER RECORDS

CASING RECORD

FORMATION	CONTENT	FROM	TO	SIZE	PUT IN	PULLED OUT

Describe in detail the manner in which the well was plugged, indicating where the mud fluid was placed and the method or methods used in introducing it into the hold. If cement or other plugs were used, state the character of same and depth placed, from \_\_\_\_\_ feet to \_\_\_\_\_ feet for each plug set.

T.D. 3920'

Set 1st plug at 1050' with 70 sx.

2nd plug at 200' with 20 sx.

40' solid bridge with 10 sx.

JAN 25 1977

01-25-1977

Plug was down at 9:30 p.m. 1-19-77

State Plugger - Gilbert Balthazor.

Wichita, Kansas

(If additional description is necessary, use BACK of this sheet)

Name of Plugging Contractor Abercrombie Drilling, Inc.

STATE OF Kansas COUNTY OF Sedgwick ss.  
Jack L. Partridge, Asst. Sec.-Treas.

(employee of owner) or (owner or operator) of the above-described well, being first duly sworn on oath, says: That I have knowledge of the facts, statements, and matters herein contained and the log of the above-described well as filed and that the same are true and correct. So help me God.

(Signature) *Jack L. Partridge*

801 Union Center, Wichita, Kansas 67202  
(Address)

Subscribed and Sworn to before me this 21st day of January, 1977

My commission expires \_\_\_\_\_

*Kathy S. Goertz*  
Kathy S. Goertz

Notary Public.

