


STATE OF KANSAS
STATE CORPORATION COMMISSION

Give All Information Completely
Make Required Affidavit
Mail or Deliver Report to:
Conservation Division
State Corporation Commission
800 Bittling Building
Wichita, Kansas

15-137-00096-00-00

WELL PLUGGING RECORD

NORTH

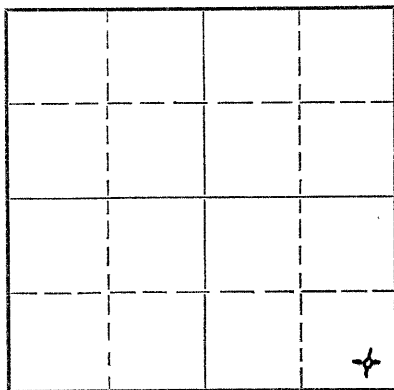

Locate well correctly on above
Section Plat

Norton County. Sec. 17 Twp. 3 S Rge. 25 (E) W (W)
Location as "NE/CNW/SW" or footage from lines SE SE SE
Lease Owner Anderson-Prichard Oil Corporation
Lease Name Brooks Well No. 1
Office Address Liberty Bank Building, Oklahoma City, Oklahoma
Character of Well (completed as Oil, Gas or Dry Hole) Dry hole
Date well completed July 4, 1953
Application for plugging filed July 4, 1953
Application for plugging approved July 4, 1953
Plugging commenced July 4, 1953
Plugging completed July 4, 1953
Reason for abandonment of well or producing formation Dry hole

If a producing well is abandoned, date of last production _____ 19____
Was permission obtained from the Conservation Division or its agents before plugging was commenced? Yes

Name of Conservation Agent who supervised plugging of this well Eldon Petty
Producing formation _____ Depth to top _____ Bottom _____ Total Depth of Well 3895 Feet
Show depth and thickness of all water, oil and gas formations.

OIL, GAS OR WATER RECORDS

CASING RECORD

FORMATION	CONTENT	FROM	TO	SIZE	PUT IN	PULLED OUT
		0	205	8 5/8	205	None

Describe in detail the manner in which the well was plugged, indicating where the mud fluid was placed and the method or methods used in introducing it into the hole. If cement or other plugs were used, state the character of same and depth placed, from _____ feet to _____ feet for each plug set.

From 3895' to 191 1/2' - heavy rotary mud
191 1/2' to 190' - wooden plug
190' to 144' - 15 sacks cement
144' to 41 1/2' - heavy rotary mud
41 1/2' to 40' - wooden plug
40' to 6' - 10 sacks cement
6' to surface - cellar

RECEIVED
STATE CORPORATION COMMISSION
JUL 9 1953
07-09-1953
CONSERVATION DIVISION
Wichita, Kansas

(If additional description is necessary, use BACK of this sheet)
Name of Plugging Contractor Glenn W. Peel
Address P.O. Box 359, Hoisington, Kansas

STATE OF Kansas, COUNTY OF Barton, ss.
Glenn W. Peel (employee of owner) or (~~owner or operator~~) of the above-described well, being first duly sworn on oath, says: That I have knowledge of the facts, statements, and matters herein contained and the log of the above-described well as filed and that the same are true and correct. So help me God. GLENN W. PEEL

(Signature) BY: Maniam M. Herbert
P.O. ^Box 359, Hoisington, Kansas
(Address)

SUBSCRIBED AND SWORN TO before me this 7th day of July, 1953

Maniam M. Herbert
Notary Public.

My commission expires June 4, 1955

PLUGGING
FILE SEC 17 T 3 R 250
BOOK PAGE 113 LINE 13

24-7368-S 3-53-20M