

P

15-137-30085-00-00


Form CP-4

STATE OF KANSAS  
STATE CORPORATION COMMISSION

### WELL PLUGGING RECORD

Give All Information Completely  
Make Required Affidavit  
Mail or Deliver Report to:  
Conservation Division  
State Corporation Commission  
211 No. Broadway  
Wichita, Kansas

Norton County, Sec. 16 Twp. 3S Rge. (E) 25 (W)  
Location as "NE/CNW/SW" or footage from lines Cen. SW NW

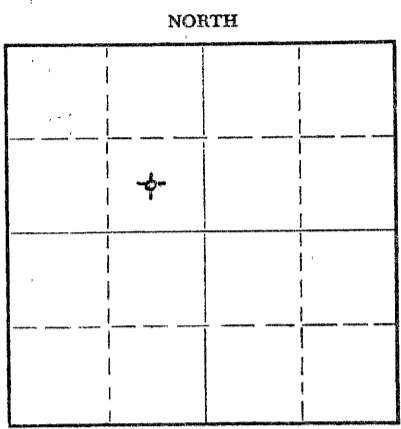

Locate well correctly on above Section Plat

Lease Owner Lario Oil & Gas Company  
 Lease Name Alvin Schoen Well No. 1  
 Office Address 301 S. Market, Wichita, Kansas 67202  
 Character of Well (completed as Oil, Gas or Dry Hole) Dry Hole  
 Date well completed December 16 19 66  
 Application for plugging filed (written 12-28-66) December 16 19 66  
 Application for plugging approved December 16 19 66  
 Plugging commenced December 16 19 66  
 Plugging completed December 16 19 66  
 Reason for abandonment of well or producing formation Dry Hole

If a producing well is abandoned, date of last production 19  
 Was permission obtained from the Conservation Division or its agents before plugging was commenced? Yes

Name of Conservation Agent who supervised plugging of this well Bill Nichols, Moreland, Kansas  
 Producing formation \_\_\_\_\_ Depth to top \_\_\_\_\_ Bottom \_\_\_\_\_ Total Depth of Well 3890 Feet  
 Show depth and thickness of all water, oil and gas formations.

#### OIL, GAS OR WATER RECORDS

#### CASING RECORD

FORMATION	CONTENT	FROM	TO	SIZE	PUT IN	PULLED OUT
				8 5/8	360	None

Describe in detail the manner in which the well was plugged, indicating where the mud fluid was placed and the method or methods used in introducing it into the hole. If cement or other plugs were used, state the character of same and depth placed, from \_\_\_\_\_ feet to \_\_\_\_\_ feet for each plug set.

- 25 sacks cement at 600'
- 20 sacks cement at 300'
- 10 sacks cement at 40'

DEC 30 1966  
 CONSERVATION DIVISION  
 Wichita, Kansas

(If additional description is necessary, use BACK of this sheet)  
 Name of Plugging Contractor Murfin Drilling Company  
 Address 617 Union Center, Wichita, Kansas 67202

STATE OF Kansas, COUNTY OF Sedgwick, ss.  
Orville H. Hinerman, Jr. (employee of owner) or (owner or operator) of the above-described well, being first duly sworn on oath, says: That I have knowledge of the facts, statements, and matters herein contained and the log of the above-described well as filed and that the same are true and correct. So help me God.

(Signature) Orville H. Hinerman, Jr.  
301 S. Market, Wichita, Kansas 67202  
 (Address)

SUBSCRIBED AND SWORN TO before me this 28th day of December, 19 66

My commission expires July 21, 1970  
Frances Leslie  
 Notary Public.

WELL LOG


15-137-30085-00-00

COMPANY Lario Oil & Gas  
FARM Alvin Schoen NO. One

SEC. 16 T. 3S R. 25W  
LOC. C SW NW

RIG. NO. 16  
TOTAL DEPTH 3890'  
COMM. 12-9-66 COMP. 12-16-66  
SHOT OR TREATED  
CONTRACTOR ISSUED Murfin Drilling Company

COUNTRY Norton - Kansas  
KANSAS

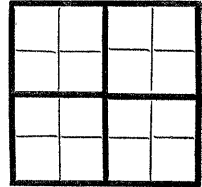

CASING  
20 10  
15 8 5/8' w/215 sacks  
12 6  
13 5

ELEVATION  
PRODUCTION Oil

FIGURES INDICATE BOTTOM OF FORMATIONS

60 Surface Clay  
300 Sand & Shale  
1165 Shale  
2051 Shale - Shells  
2085 Anhydrite  
2580 Shale & Shells  
2920 Shale & Lime  
3765 Lime & Shale  
3880 Lime - Shale  
3890 Granite Wash.

RECEIVED  
STATE CORPORATION COMMISSION

JAN 10 1967

CONSERVATION DIVISION  
Wichita, Kansas

State of KANSAS  
County of SEDGWICK } ss:

I, W. R. Murfin of the Murfin Drilling Company

upon oath state that the above and foregoing is a true and correct copy of the log of the Alvin Schoen #1 well.

Subscribed and sworn to before me this 9th day of January 19 67  
W. R. Murfin

My Commission Expires: My commission expires December 5, 1970  
ADELA MIZENER, Notary Public

Adela Mizener  
NOTARY PUBLIC