


STATE OF KANSAS
STATE CORPORATION COMMISSION

WELL PLUGGING RECORD

Give All Information Completely
Make Required Affidavit
Mail or Deliver Report to
Conservation Division
State Corporation Comm.
245 North Water
Wichita, KS 67202

Decatur County, Sec. 12 Twp. 3S Rge. 27 E/W
Location as "NE/CNW $\frac{1}{4}$ SW $\frac{1}{4}$ " or footage from lines
C NE NE

Lease Owner Argonaut Energy Corporation
Lease Name WENTZ Well No. 1
Office Address P. O. Box 12099, Amarillo, Texas 79101
Character of Well (Completed as Oil, Gas or Dry Hole)
Dry Hole

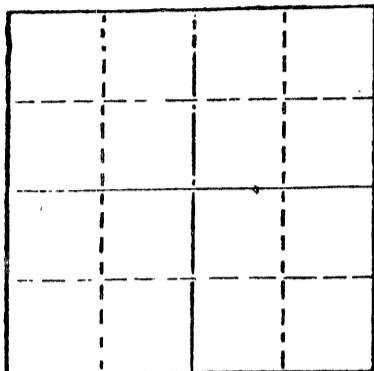

Locate well correctly on above
Section Plot

Date Well completed 8-16-78 19
Application for plugging filed 8-16-78 19
Application for plugging approved 8-16-78 19
Plugging commenced 8-16-78 19
Plugging completed 8-16-78 19

Reason for abandonment of well or producing formation
commercial quantities of oil not found.
If a producing well is abandoned, date of last production 19

Was permission obtained from the Conservation Division or
its agents before plugging was commenced? Yes

Name of Conservation Agent who supervised plugging of this well Gilbert Balthazor, Palco, Ks.
Producing formation _____ Depth to top _____ Bottom _____ Total Depth of Well 4050'
Show depth and thickness of all water, oil and gas formations.

OIL, GAS OR WATER RECORDS

CASING RECORD

FORMATION	CONTENT	FROM	TO	SIZE	PUT IN	PULLED OUT
				8-5/8"	287'	

Describe in detail the manner in which the well was plugged, indicating where the mud fluid
was placed and the method or methods used in introducing it into the hold. If cement or other
plugs were used, state the character of same and depth placed, from _____ feet to
_____ feet for each plug set.

Plug @ 1250' w/70 sx.
240' w/20 sx.
40' w/10 sx.
2 sx. in rathole

RECEIVED
STATE CORPORATION COMMISSION

AUG 25 1978

CONSERVATION DIVISION
Wichita, Kansas

8-25-78

(If additional description is necessary, use BACK of this sheet)

Name of Plugging Contractor Rains & Williamson Oil Co., Inc.

STATE OF KANSAS COUNTY OF SEDGWICK, ss.
Wilson Rains, President (employee of owner) or (owner or operator)
of the above-described well, being first duly sworn on oath, says: That I have knowledge of
the facts, statements, and matters herein contained and the log of the above-described well
as filed and that the same are true and correct. So help me God.

(Signature) Wilson Rains WILSON RAINS
435 Page Court, 220 W. Douglas, Wichita, Ks.
(Address) 67202

SUBSCRIBED AND SWORN TO before me this 18th day of August, 1978

My commission expires October 4, 1979

Juanita M. Green
Juanita M. Green Notary Public.

