

15-039-00018-00-00

STATE OF KANSAS
STATE CORPORATION COMMISSION

WELL PLUGGING RECORD

Give All Information Completely
Make Required Affidavit
Mail or Deliver Report to:
Conservation Division
State Corporation Commission
800 Bittling Building
Wichita, Kansas

OR
FORMATION PLUGGING RECORD

Strike out upper line
when reporting plug-
ging off formations.

Decatur County. Sec. 21 Twp. 3S Rge. (E) 27 (W)

Location as "NE1/4NW1/4SW1/4" or footage from lines. ~~SW SW~~

Lease Owner. A. J. Stormfeltz

Lease Name. Brown Well No. 1

Office Address. 4638 Mill Creek Parkway, Kansas City, Mo.

Character of Well (completed as Oil, Gas or Dry Hole) Dry Hole

Date well completed. Sept. 5 19 48

Application for plugging filed. Sept. 5 19 48

Application for plugging approved. Sept. 5 19 48


Plugging commenced. Sept. 5 19 48

Plugging completed. 19

Reason for abandonment of well or producing formation.

If a producing well is abandoned, date of last production. 19

Was permission obtained from the Conservation Division or its agents before plugging was commenced? Yes

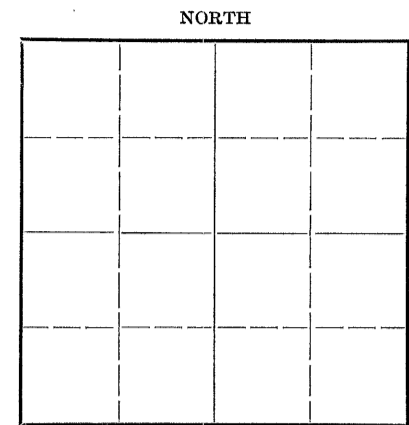

Locate well correctly on above
Section Plat

Name of Conservation Agent who supervised plugging of this well. Mr. Rives

Producing formation. Depth to top. Bottom. Total Depth of Well. Feet

Show depth and thickness of all water, oil and gas formations.

OIL, GAS OR WATER RECORDS

CASING RECORD

| Formation | Content | From | To | Size | Put In | Pulled Out |
|-----------|---------|------|------|--------|---------|------------|
| | 150 sax | 0 | 301' | 8 5/8" | 8-20-48 | |
| | | | | | | |
| | | | | | | |
| | | | | | | |
| | | | | | | |
| | | | | | | |
| | | | | | | |
| | | | | | | |
| | | | | | | |

Describe in detail the manner in which the well was plugged, indicating where the mud fluid was placed and the method or methods used in introducing it into the hold. If cement or other plugs were used, state the character of same and depth placed, from...feet to...feet for each plug set.

Filled hole with heavy mud; set wood plug @ 250';
Cemented with 15 sax bulk cement; filled with
heavy mud; set wood plug @ 30'; cemented with
10 sax bulk cement to bottom of cellar.

(If additional description is necessary, use BACK of this sheet)

Correspondence regarding this well should be addressed to. J.D. Ferrell Drilling Company, Inc.,
Address. Box 163
Great Bend, Kans.

STATE OF Kansas, COUNTY OF Barton, ss.


operator (employee of owner) or (owner or operator) of the above-described well,
being first duly sworn on oath, says: That I have knowledge of the facts, statements, and matters herein contained and the log of the above-
described well as filed and that the same are true and correct. So help me (God).

(Signature) *J.D. Ferrell*
J.D. Ferrell
Box 163, Great Bend, Kansas.
(Address)

SUBSCRIBED AND SWORN to before me this 13th day of Sept. 19 48

Merle V. Sandefur
Notary Public.

My commission expires. Oct. 15, 1951

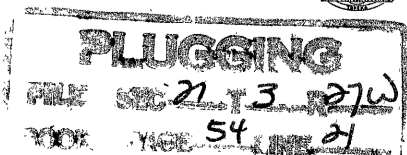

9-15-48