

15-039-00083-00-00


STATE OF KANSAS
STATE CORPORATION COMMISSION

WELL PLUGGING RECORD

Give All Information Completely
Make Required Affidavit
Mail or Deliver Report to:
Conservation Division
State Corporation Commission
800 Bitting Building
Wichita, Kansas

Decatur County, Sec. 19 Twp. 3 Rge. 27 (E) W (W)
Location as "NE/CNW $\frac{1}{4}$ SW $\frac{1}{4}$ " or footage from lines NW NW SE
Lease Owner H. E. Zoller, et al
Lease Name Monaghan (South) Well No. 1
Office Address 409 California Bldg., Denver, Colorado
Character of Well (completed as Oil, Gas or Dry Hole) dry hole
Date well completed July 27, 1954
Application for plugging filed July 27, 1954
Application for plugging approved August 2, 1954
Plugging commenced July 27, 1954
Plugging completed July 27, 1954
Reason for abandonment of well or producing formation dry hole, no shows

NORTH

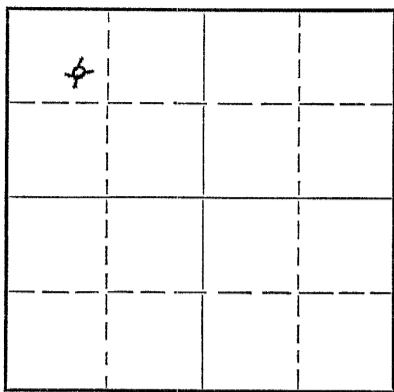

Locate well correctly on above
Section Plat

If a producing well is abandoned, date of last production nil 19
Was permission obtained from the Conservation Division or its agents before plugging was commenced? yes

Name of Conservation Agent who supervised plugging of this well Eldon Petty, Hays, Kansas.
Producing formation nil Depth to top nil Bottom nil Total Depth of Well 4268' (KFB)
Show depth and thickness of all water, oil and gas formations. 4263' (G.L.)

OIL, GAS OR WATER RECORDS

CASING RECORD

Formation	Content	From	To	Size	Put In	Pulled Out
none						

Describe in detail the manner in which the well was plugged, indicating where the mud fluid was placed and the method or methods used in introducing it into the hole. If cement or other plugs were used, state the character of same and depth placed, from feet to feet for each plug set.

Hole was filled with drilling mud to 260'; 1/2 sack hulls placed @ 260' and 15 sacks cement; top plug @ 40', 1/2 sack hulls and 10 sacks cement to surface.

RECEIVED
STATE CORPORATION COMMISSION
AUG 12 1954
CONSERVATION DIVISION
8-12-54

Name of Plugging Contractor Bill Hay Drilling Co.
Address 371 West 3rd Street, Hoisington, Kansas.

STATE OF Colorado, COUNTY OF Denver, ss.
H. E. Zoller (employee of owner) or (owner or operator) of the above-described well,

being first duly sworn on oath, says: That I have knowledge of the facts, statements and matters herein contained and the log of the above-described well as filed and that the same are true and correct. So help me God.

(Signature) *H. E. Zoller*
409 California Bldg., Denver, Colorado.
(Address)

SUBSCRIBED AND SWORN to before me this 6th day of August, 1954.

My commission expires March 4, 1956
Beatrice M. Bishop
Notary Public.

28-8390-s 6-51-20M

PLUGGING
FILE NO. 19 T 3 R 27W
BOOK PAGE 53 LINE 5