


STATE OF KANSAS
STATE CORPORATION COMMISSION

Give All Information Completely
Make Required Affidavit
Mail or Deliver Report to:
Conservation Division
State Corporation Commission
800 Biting Building
Wichita, Kansas

WELL PLUGGING RECORD

15-039-00069-00-00

NORTH

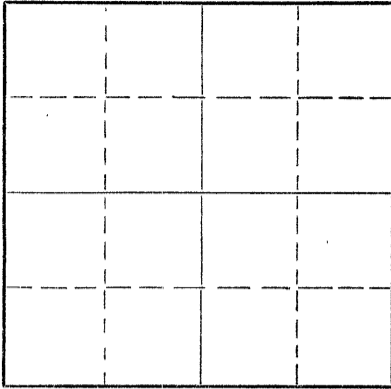

Locate well correctly on above Section Plat

Decatur County, Sec. 14 Twp. 3 Rge. 27 (X) (W)

Location as "NE/CNW/SW" or footage from lines SW SW SW
Lease Owner Musgrove Petroleum Corporation
Lease Name Bailey Well No. 1
Office Address 518 Petroleum Building, Wichita, Kansas
Character of Well (completed as Oil, Gas or Dry Hole) Dry Hole
Date well completed January 19, 19 53
Application for plugging filed January 23, 19 53
Application for plugging approved _____ 19 _____
Plugging commenced January 19, 19 53
Plugging completed January 19, 19 53
Reason for abandonment of well or producing formation Dry

If a producing well is abandoned, date of last production _____ 19 _____
Was permission obtained from the Conservation Division or its agents before plugging was commenced? Yes

Name of Conservation Agent who supervised plugging of this well Unknown
Producing formation _____ Depth to top _____ Bottom _____ Total Depth of Well 4060 Feet
Show depth and thickness of all water, oil and gas formations.

OIL, GAS OR WATER RECORDS

CASING RECORD

| FORMATION | CONTENT | FROM | TO | SIZE | PUT IN | PULLED OUT |
|-----------|---------|------|----|-------|--------|------------|
| | | | | 8 5/8 | 285.51 | |
| | | | | | | |
| | | | | | | |
Describe in detail the manner in which the well was plugged, indicating where the mud fluid was placed and the method or methods used in introducing it into the hole. If cement or other plugs were used, state the character of same and depth placed, from _____ feet to _____ feet for each plug set.

Set bottom plug at 265' with 15 sacks of cement.
Set top plug at 40' with 10 sacks of cement and 1/2 sack of hulls

(If additional description is necessary, use BACK of this sheet)

Name of Plugging Contractor Musgrove Petroleum Corporation
Address 518 Petroleum Building, Wichita, Kansas

STATE OF Kansas, COUNTY OF Sedgwick, ss.
Gordon L. Koelling (employee of owner) or (owner or operator) of the above-described well, being first duly sworn on oath, says: That I have knowledge of the facts, statements, and matters herein contained and the log of the above-described well as filed and that the same are true and correct. So help me God.

(Signature) Gordon L. Koelling
518 Petroleum Bldg, Wichita, Kansas
(Address)

SUBSCRIBED AND SWORN to before me this 23rd day of January 19 53
Mary S. [Signature]
Notary Public.

My commission expires November 14, 1956

PLUGGING
FILE SEC 14 T 3 R 27W
BOOK PAGE 75 LINE 10

RECEIVED
STATE CORPORATION COMMISSION
JAN 24 1953
CONSERVATION DIVISION
Wichita, Kansas
1-24-53