


15-039-20103-00-00

STATE OF KANSAS
STATE CORPORATION COMMISSION

Give All Information Completely
Make Required Affidavit
Mail or Deliver Report to:
Conservation Division
State Corporation Commission
P. O. Box 17027
Wichita, Kansas 67217
NORTH

WELL PLUGGING RECORD

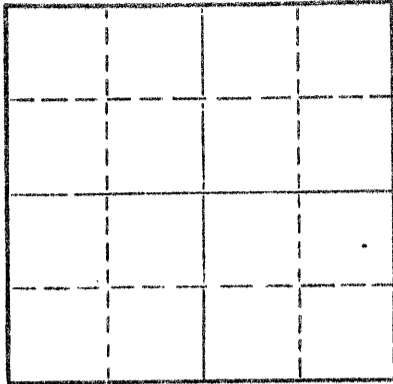

Locate well correctly on above
Section Plat

Decatur County, Sec. 10 Twp. 3 Rge. 27 (E) (W) E
Location as "NE/CNWXSW" or footage from lines C of SW SE
Lease Owner Okmar Oil Co.
Lease Name Gillespie Well No. #1
Office Address 1130 Vickers KSB&T Bldg. Wichita, Kansas
Character of Well (completed as Oil, Gas or Dry Hole)
Date well completed 19
Application for plugging filed 19
Application for plugging approved 19
Plugging commenced 2-15-74 19
Plugging completed 2-21-74 19
Reason for abandonment of well or producing formation

If a producing well is abandoned, date of last production 19
Was permission obtained from the Conservation Division or its agents before plugging was commenced?

Name of Conservation Agent who supervised plugging of this well W. L. Nichols
Producing formation Depth to top Bottom Total Depth of Well 3865' Feet
Show depth and thickness of all water, oil and gas formations.

OIL, GAS OR WATER RECORDS

CASING RECORD

FORMATION	CONTENT	FROM	TO	SIZE	PUT IN	PULLED OUT
				5 1/2"	3864'	2856.44'
				8 5/8"	232'	

Describe in detail the manner in which the well was plugged, indicating where the mud fluid was placed and the method or methods used in introducing it into the hole. If cement or other plugs were used, state the character of same and depth placed, from feet to feet for each plug set.

Made bottom hole plug back with sand to 3600'. Mixed and ran 5 sacks cement thru dump bailer.

Squeezed hole 110 cu. ft cement 1425' - 1100'
21 sacks gel 1100' - 260'
30 cu. ft. cement 260' - 190'
4 sacks gel ; 190' - 30'
10 cu. ft. cement 30' - base of cellar

RECEIVED
STATE CORPORATION COMMISSION
FEB 26 1974
CONSERVATION DIVISION
Wichita, Kansas

2-26-74

(If additional description is necessary, use BACK of this sheet)
Name of Plugging Contractor Southwest Casing Pulling Co.
Address Box 364 Great Bend, Kansas

STATE OF Kansas, COUNTY OF Barton, ss.
Southwest Casing Pulling Co. (employee of owner) or (owner or operator) of the above-described well, being first duly sworn on oath, says: That I have knowledge of the facts, statements, and matters herein contained and the log of the above-described well as filed and that the same are true and correct. So help me God.

(Signature) W. C. Spencer Sec.
Box 364 Great Bend, Kansas (Address)

Subscribed and Sworn to before me this 25 day of February, 1974

My commission expires October 1976
Notary Public

Sidney D. Miller
Notary Public