

CARD MUST BE TYPED

State of Kansas
NOTICE OF INTENTION TO DRILL
(see rules on reverse side)

CARD MUST BE SIGNED

Starting Date: 8 1 85
month day year

API Number 15- 039-20,774-000

OPERATOR: License # 5135
Name John O. Farmer, Inc.
Address P.O. Box 352
City/State/Zip Russell, KS 67665
Contact Person Sam Farmer
Phone (913) 483-3144

NW NW NW Sec 30 Twp 3 S, Rge 26 East
(location) West
..... 4950 Ft North from Southeast Corner of Section
..... 4950 Ft West from Southeast Corner of Section
(Note: Locate well on Section Plat on reverse side)

CONTRACTOR: License # 5135
Name John O. Farmer, Inc.
City/State Russell, KS 67665

Nearest lease or unit boundary line 330 feet.
County Decatur

Well Drilled For: Well Class: Type Equipment:
 Oil Swd Infield Mud Rotary
 Gas Inj Pool Ext. Air Rotary
 OWWO Expl Wildcat Cable

Lease Name Cecil Well# 1
Domestic well within 330 feet: yes no
Municipal well within one mile: yes no

If OWWO: old well info as follows:
Operator
Well Name
Comp Date Old Total Depth
Projected Total Depth 3825 feet
Projected Formation at TD Lansing/KG
Expected Producing Formations Lansing/KG

Production string will be cemented from Anhy. to surface upon completion of well. 100 feet
Depth to Bottom of fresh water 150
Lowest usable water formation Dakota
Depth to Bottom of usable water 1450 feet
Surface pipe by Alternate: 1 2
Surface pipe to be set 220 feet
Conductor pipe if any required none feet
Ground surface elevation 2620 Est. ... feet MSL
This Authorization Expires 1-23-86
Approved By PCN 7-23-85

I certify that we will comply with K.S.A. 55-101, et seq., plus eventually plugging hole to K.C.C. specifications.


Date 7-22-85 Signature of Operator or Agent John O. Farmer, Inc. Title Vice-president
Form C-1 4/84

Must be filed with the K.C.C. five (5) days prior to commencing well
 This card void if drilling not started within six (6) months of date received by K.C.C.

RECEIVED
 STATE CORPORATION COMMISSION

7-23-85

FULL 23 1985
 A Regular Section of Land
 1 Mile = 5,280 Ft.
 CONSERVATION DIVISION
 Wichita, Kansas

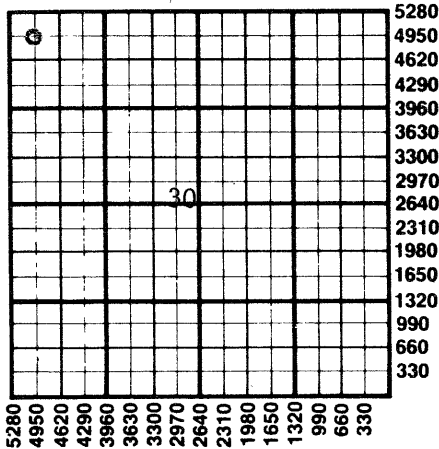

Important procedures to follow :

1. Notify District office before setting surface casing.
2. Set surface casing by circulating cement to the top.
3. File completion forms ACO-1 with K.C.C. within 90 days of well completion, following instructions on ACO-1, side 1, and including copies of wireline logs.
4. Notify District office 48 hours prior to old well workover or re-entry.
5. Prior to plugging, prepare a plugging plan, then obtain agreement from the appropriate district office for an approved plugging plan.
6. Submit plugging report (CP-4) to K.C.C. after plugging is completed.
7. Obtain an approved injection docket number before disposing of salt water.
8. Notify K.C.C. within 10 days when injection commences or terminates.
9. If an alternate 2 completion, cement in the production pipe from below any usable water to surface within 120 days of spud date.

State Corporation Commission of Kansas
 Conservation Division
 200 Colorado Derby Building
 Wichita, Kansas 67202
 (316) 263-3238