

CARD MUST BE TYPED

State of Kansas
NOTICE OF INTENTION TO DRILL
(see rules on reverse side)

CARD MUST BE SIGNED

Starting Date: 11 30 85
month day year

API Number 15- 039-20,785-00-00

OPERATOR: License # 5375

SE NW SW Sec 11 Twp 3 S, Rge 27 East
(location) West

Name Hillenburg Oil Co.

Address 116th & S. Lynn Lane

City/State/Zip Broken Arrow, OK. 74012

Contact Person Harold Hillenburg, Jr.

Phone 918/455-4444

1650 Ft North from Southeast Corner of Section

4290 Ft West from Southeast Corner of Section

(Note: Locate well on Section Plat on reverse side)

CONTRACTOR: License # 5420

Name White & Ellis Drilling, Inc.

City/State Wichita, KS. 67202

Nearest lease or unit boundary line 990 feet.

County Decatur

Lease Name Packer Well# 1

Domestic well within 330 feet : yes no

Municipal well within one mile : yes no

Well Drilled For: Well Class: Type Equipment:

- Oil Swd Infield Mud Rotary
- Gas Inj Pool Ext. Air Rotary
- OWWO Expl Wildcat Cable

If OWWO: old well info as follows:

Operator

Well Name

Comp Date Old Total Depth

Projected Total Depth 4600' feet

Projected Formation at TD Mississippi

Expected Producing Formations Mississippi

Depth to Bottom of fresh water 200' feet

Lowest usable water formation Conglomerate Dalata

Depth to Bottom of usable water ~~200~~ 1500 feet


Surface pipe by Alternate : 1 2

Surface pipe to be set 250' feet

Conductor pipe if any required None feet

Ground surface elevation 2676 feet MSL

This Authorization Expires 5-25-86

Approved By 11-25-85 

I certify that we will comply with K.S.A. 55-101, et seq., plus eventually plugging hole to K.C.C. specifications.

White & Ellis Drlg., Inc
Secretary-Treasurer

Date 11-25-85 Signature of Operator or Agent  Title

Ernest Safford


Form C-1 4/84



Must be filed with the K.C.C. five (5) days prior to commencing well
This card void if drilling not started within six (6) months of date received by K.C.C.

RECEIVED
STATE CORPORATION COMMISSION
A Regular Section of Land 11-23-85
1 Mile = 5,280 Ft. NOV 25 1985

Important procedures to follow :

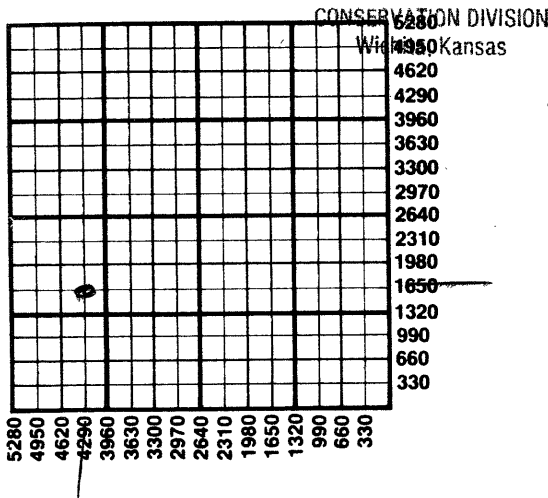

1. Notify District office before setting surface casing.
2. Set surface casing by circulating cement to the top.
3. File completion forms ACO-1 with K.C.C. within 90 days of well completion, following instructions on ACO-1, side 1, and including copies of wireline logs.
4. Notify District office 48 hours prior to old well workover or re-entry.
5. Prior to plugging, prepare a plugging plan, then obtain agreement from the appropriate district office for an approved plugging plan.
6. Submit plugging report (CP-4) to K.C.C. after plugging is completed.
7. Obtain an approved injection docket number before disposing of salt water.
8. Notify K.C.C. within 10 days when injection commences or terminates.
9. If an alternate 2 completion, cement in the production pipe from below any usable water to surface within 120 days of spud date.

State Corporation Commission of Kansas
Conservation Division
200 Colorado Derby Building
Wichita, Kansas 67202
(316) 263-3238