

CARD MUST BE TYPED

State of Kansas

CARD MUST BE SIGNED

NOTICE OF INTENTION TO DRILL

(see rules on reverse side)

Starting Date September 24, 1986
month day year

API Number 15- 039-10,795-06-00

OPERATOR: License # 5255
Name McGinness Oil Company
Address 1026 Union Center Bldg.
City/State/Zip Wichita, KS 67202
Contact Person Doug McGinness
Phone (316) 267-6065

SW NE SE Sec. 10 Twp. 3 S, Rg. 27 X West
1650 Ft. from South Line of Section
990 Ft. from East Line of Section

(Note: Locate well on Section Plat on reverse side)

CONTRACTOR: License # 5302
Name Red Tiger Drilling Company
City/State Wichita, Kansas

Nearest lease or unit boundary line 990 feet
County Decatur

Lease Name Gillespie Well # 1-10

Ground surface elevation feet MSL

Well Drilled For: Well Class: Type Equipment:
X Oil SWD Infield X Mud Rotary
Gas Inj Pool Ext Air Rotary
OWWO Expl X Wildcat Cable

Domestic well within 330 feet: yes X no
Municipal well within one mile: yes X no

Depth to bottom of fresh water 200!

Depth to bottom of usable water 1550!

Surface pipe by Alternate: 1 2 X

If OWWO: old well info as follows:

Surface pipe planned to be set 250!

Conductor pipe required None

Projected Total Depth 3850! feet

Formation "Tight Hole"

I certify that well will comply with K.S.A. 55-101, et seq., plus eventually plugging hole to KCC specifications.

Date 09-15-86 Signature of Operator or Agent Doug McGinness Title President

For KCC Use:

Conductor Pipe Required feet; Minimum Surface Pipe Required 250 feet per Alt.

This Authorization Expires 3-16-87 Approved By 9-13-86


RCH/KCC [Signature]

Must be filed with the K.C.C. five (5) days prior to commencing well
 This card void if drilling not started within six (6) months of date received by K.C.C.

Important procedures to follow:

1. Notify District office before setting surface casing.
2. Set surface casing by circulating cement to the top.
3. File completion forms ACO-1 with K.C.C. within 90 days of well completion, following instructions on ACO-1, side 1, and including copies of wireline logs.
4. Notify District office 48 hours prior to old well workover or re-entry.
5. Prior to filing Intent, prepare a proposed plugging plan in case well is D & A, then obtain approval of plan when calling district office prior to setting surface pipe.
6. Submit plugging report (CP-4) to K. C. C. after plugging is completed.
7. Obtain an approved injection docket number before disposing of salt water.
8. Notify K.C.C. within 10 days when injection commences or terminates.
9. If an alternate 2 completion, cement in the production pipe from below any usable water to surface within 120 days of spud date.

A Regular Section of Land
1 Mile = 5,280 Ft.

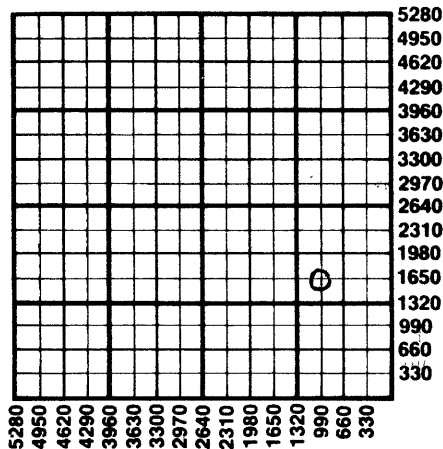

SEP 16 1986

9-16-86

State Corporation Commission of Kansas
 Conservation Division
 200 Colorado Derby Building
 Wichita, Kansas 67202
 (316) 263-3238