

CARD MUST BE TYPED

State of Kansas

CARD MUST BE SIGNED

NOTICE OF INTENTION TO DRILL

(see rules on reverse side)

"CORRECTED SPOT LOCATION"

Starting Date 2 19 87 month day year

API Number 15- 039-20,807-00-00 2-19-87

OPERATOR: License # 8981

Approved SE SE NW Sec. 4 Twp. 3S S, Rg. 27W X East

Name ADECO INC & CHAMBERS

Address 310 E. Ash

City/State/Zip Oberlin, Kansas 67749

Contact Person Lester L. Chambers

Phone 913-475-3468

2970 Ft. from South Line of Section
2970 Ft. from East Line of Section

(Note: Locate well on Section Plat on reverse side)

Nearest lease or unit boundary line 330 feet

County Decatur

Lease Name Richard Chambers Well # 1

CONTRACTOR: License # 5302

Name Red Tiger Drilling Co.

City/State Wichita, Kansas 67202

Ground surface elevation 2670 feet MSL

Domestic well within 330 feet: yes X no

Well Drilled For: Well Class: Type Equipment:

X Oil SWD Infield X Mud Rotary

Gas Inj X Pool Ext Air Rotary

OWWO Expl Wildcat Cable

Municipal well within one mile: yes X no

Depth to bottom of fresh water 200

Depth to bottom of usable water 1500

Surface pipe by Alternate: 1 2 X

If OWWO: old well info as follows:

Surface pipe planned to be set 280

Operator

Conductor pipe required N/A

Well Name

Projected Total Depth 4200 feet

Comp Date Old Total Depth

Formation granite

I certify that well will comply with K.S.A. 55-101, et seq., plus eventual amendments.

Date 2/19/87 Signature of Operator or Agent

Handwritten signature of Raymond A. Oyle

BY RED TIGER DRILLING CO.

For KCC Use: Conductor Pipe Required 250 feet; Minimum Surface Pipe Required 250 feet per Alt. 2

This Authorization Expires 8-12-87 Approved By 2-12-87


Handwritten notes: kwas. NW SW NW 3630 FSL 4950 FEL

Must be filed with the K.C.C. five (5) days prior to commencing well
 This card void if drilling not started within six (6) months of date received by K.C.C.

Important procedures to follow:

1. Notify District office before setting surface casing.
2. Set surface casing by circulating cement to the top.
3. File completion forms ACO-1 with K.C.C. within 90 days of well completion, following instructions on ACO-1, side 1, and including copies of wireline logs.
4. Notify District office 48 hours prior to old well workover or re-entry.
5. Prior to filing Intent, prepare a proposed plugging plan in case well is D & A, then obtain approval of plan when calling district office prior to setting surface pipe.
6. Submit plugging report (CP-4) to K. C. C. after plugging is completed.
7. Obtain an approved injection docket number before disposing of salt water.
8. Notify K.C.C. within 10 days when injection commences or terminates.

**A Regular Section of Land
 1 Mile = 5,280 Ft.**

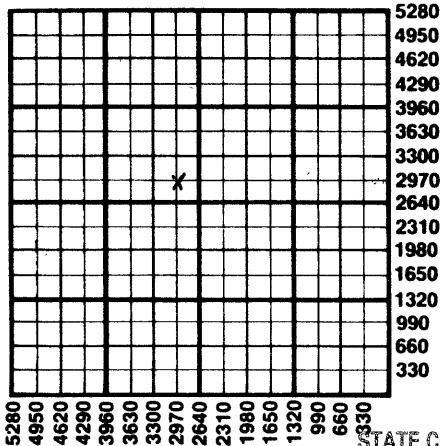

RECEIVED
 STATE CORPORATION COMMISSION

9. If an alternate 2 completion, cement in the production pipe from below any usable water to surface within 120 days of spud date.

FEB 19 1987
 2-19-87
 CONSERVATION DIVISION
 Wichita, Kansas

State Corporation Commission of Kansas
 Conservation Division
 200 Colorado Derby Building
 Wichita, Kansas 67202
 (316) 263-3238