

15-

3

This form shall be filed in duplicate with the Kansas Corporation Commission, 200 Colorado Derby Building, Wichita, Kansas 67202, within ten days after the completion of the well, regardless of how the well was completed.

Attach separate letter of request if the information is to be held confidential. If confidential, only file one copy. Information on side one will be of public record and side two will then be held confidential.

Circle one: Oil, Gas, Dry, SWD, OWWO, Injection. Type and complete ALL sections.

Applications must be filed for dual completion, commingling, SWD and injection, T.A.

Attach wireline logs (i.e. electrical log, sonic log, gamma ray neutron log, etc.).

KCC # (316) 263-3238. (Rules 82-2-105 & 82-2-125)

OPERATOR S & W Drilling Co., Inc.

API NO. 15-039-20649 -00-00

ADDRESS P O Box 132 Oberlin, Kansas 67749

COUNTY Decatur

FIELD Wildcat

**CONTACT PERSON James L Reeves

PROD. FORMATION none

PHONE 913-475-3325

LEASE Montgomery

PURCHASER none

WELL NO. 12-12

ADDRESS

WELL LOCATION nw sw 12-3S-27W

DRILLING Murfin Drilling Co.

560 Ft. from west Line and

CONTRACTOR

660 Ft. from north Line of

ADDRESS 617 Union Center

the SW/4 SEC. 12 TWP. 3S RGE. 27W


Wichita, Kansas 67202

WELL PLAT

PLUGGING Sun Oilwell Cementing Co.

CONTRACTOR

ADDRESS Great Bend, Kansas

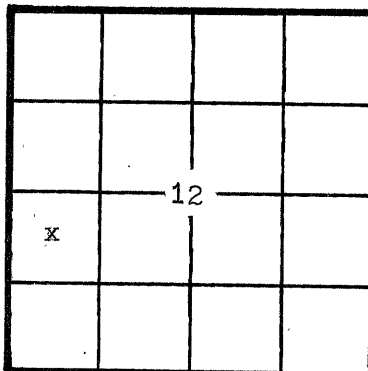

KCC (checked) KGS (checked) (Office Use)

TOTAL DEPTH 3850 PBD

SPUD DATE 4-21-82 DATE COMPLETED 4-28-82

ELEV: GR 2651 DF KB 2656

DRILLED WITH (CABLE) (ROTARY) (AIR) TOOLS

Amount of surface pipe set and cemented 8 5/8 @ 263' 7 @ 2240 DV Tool Used? no

AFFIDAVIT

STATE OF Kansas, COUNTY OF Decatur SS, I,

James L. Reeves OF LAWFUL AGE, BEING FIRST DULY SWORN UPON HIS OATH,

DEPOSES THAT HE IS Consultant (FOR) (OF) S.&W Drilling Co., Inc.

OPERATOR OF THE Montgomery LEASE, AND IS DULY AUTHORIZED TO MAKE

THIS AFFIDAVIT FOR AND ON THE BEHALF OF SAID OPERATOR, THAT WELL NO. 12-12 ON

SAID LEASE HAS BEEN COMPLETED AS OF THE 9 DAY OF June, 19 82, AND THAT

ALL INFORMATION ENTERED HEREIN WITH RESPECT TO SAID WELL IS TRUE AND CORRECT.

FURTHER AFFIANT SAITH NOT.

(S) James L. Reeves


SUBSCRIBED AND SWORN BEFORE ME THIS TENTH DAY OF JUNE, 19 82.

Helen D. Beall NOTARY PUBLIC

MY COMMISSION EXPIRES: 12/22/82

**The person who can be reached by phone regarding any questions concerning this information. Within 45 days of completion, a witnessed initial test by the Commission is required if the well produces more than 25 BOPD or is located in a Basic Order Pool.

Rec'd 6-10-82

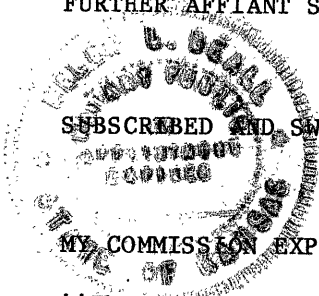

WELL LOG

Show all important zones of porosity and contents thereof; cored intervals, and all drill-stem tests, including depth interval tested, cushion used, time tool open, flowing and shut-in pressures, and recoveries.

SHOW GEOLOGICAL MARKERS, LOGS RUN, OR OTHER DESCRIPTIVE INFORMATION.

FORMATION DESCRIPTION, CONTENTS, ETC.	TOP	BOTTOM	NAME	DEPTH
Surface soil & sand	0	263	anhydrite	2216
shale	263	267	Topeka	3444
sand and shale	267	2217	Heebner	3562
anhydrite	2217	2250	Toronto	3592
sand and shale	2250	3008	Lansing	3608
shale and limestone	3008	3850	Base KC	3807
			Great Guns RA Guard W/ GR Caliper logs	

Report of all strings set — surface, intermediate, production, etc. CASING RECORD (New) or (Used)

Purpose of string	Size hole drilled	Size casing set (in O.D.)	Weight lbs/ft.	Setting depth	Type cement	Sacks	Type and percent additives
surface	12 1/4	8 5/8	20	263	60/40 poz	225	3% cc 2% gel
intermediate	7 7/8	7	20	2240	60/40 poz	60	3% cc 2% gel

LINER RECORD

PERFORATION RECORD

Top, ft.	Bottom, ft.	Sacks cement	Shots per ft.	Size & type	Depth interval

TUBING RECORD		
Size	Setting depth	Packer set at

ACID, FRACTURE, SHOT, CEMENT SQUEEZE RECORD

Amount and kind of material used	Depth interval treated

Date of first production	Producing method (flowing, pumping, gas lift, etc.)	Gravity
--------------------------	---	---------

RATE OF PRODUCTION PER 24 HOURS	Oil bbls.	Gas bbls.	Water % MCF	Gas-oil ratio bbls.	CFPB
---------------------------------	-----------	-----------	-------------	---------------------	------

Disposition of gas (vented, used on lease or sold)	Perforations
--	--------------

