

CARD MUST BE TYPED

State of Kansas
NOTICE OF INTENTION TO DRILL
(see rules on reverse side)

CARD MUST BE SIGNED

Starting Date: November 8 1984
month day year

API Number 15- 039-20,753-00-00

OPERATOR: License # 5011
Name Viking Resources
Address 217 E. William
City/State/Zip Wichita, Ks 67202-4005
Contact Person Jim Devlin
Phone 316-262-2502

Approx. NE SW NE Sec 24 . Twp . 3 . S, Rge . 27
(location) East West
3525 Ft North from Southeast Corner of Section
1545 Ft West from Southeast Corner of Section
(Note: Locate well on Section Plat on reverse side)

CONTRACTOR: License # 5420
Name White and Ellis Drilling, Inc.
City/State Wichita, KS 67202-3484

Nearest lease or unit boundary line 885 feet.
County Decatur
Lease Name Bremer Well# 1
Domestic well within 330 feet: yes no
Municipal well within one mile: yes no

Well Drilled For: **Well Class:** **Type Equipment:**
 Oil Swd Infield Mud Rotary
 Gas Inj Pool Ext. Air Rotary
 OWWO Expl Wildcat Cable

Depth to Bottom of fresh water 150 feet
Lowest usable water formation Dakota
Depth to Bottom of usable water 1450 feet

If OWWO: old well info as follows:
Operator
Well Name
Comp Date Old Total Depth
Projected Total Depth 3800 feet
Projected Formation at TD Base Kansas City
Expected Producing Formations Lansing-Kansas City

Surface pipe by Alternate: 1 2
Surface pipe to be set 240 feet
Conductor pipe if any required feet
Ground surface elevation 2600 Est feet MSL
This Authorization Expires 4-25-85
Approved By 10-25-84

I certify that we will comply with K.S.A. 55-101, et seq., plus eventually plugging hole to K.C.C. specifications.


Date 24 October 1984 Signature of Operator or Agent Title Operator

mhc/WONE 10/25/84 Form C-1 4/84

**Must be filed with the K.C.C. five (5) days prior to commencing well
This card void if drilling not started within six (6) months of date received by K.C.C.**

Important procedures to follow :

**A Regular Section of Land
1 Mile = 5,280 Ft.**

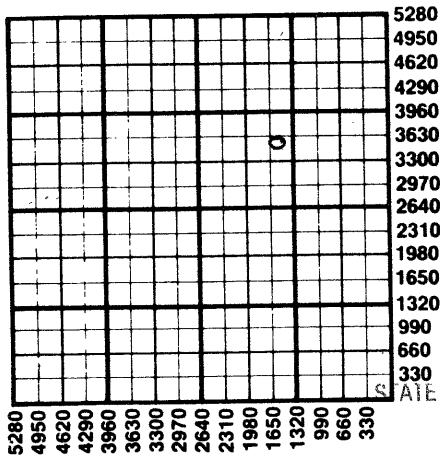

1. Notify District office before setting surface casing.
2. Set surface casing by circulating cement to the top.
3. File completion forms ACO-1 with K.C.C. within 90 days of well completion, following instructions on ACO-1, side 1, and including copies of wireline logs.
4. Notify District office 48 hours prior to old well workover or re-entry.
5. Prior to plugging, prepare a plugging plan, then obtain agreement from the appropriate district office for an approved plugging plan.
6. Submit plugging report (CP-4) to K.C.C. after plugging is completed.
7. Obtain an approved injection docket number before disposing of salt water.
8. Notify K.C.C. within 10 days when injection commences or terminates.

9. If an alternate 2 completion, cement in the production pipe from below any usable water to surface within 120 days of spud date.

RECEIVED

STATE CORPORATION COMMISSION

OCT 25 1984
10-25-84
CONSERVATION DIVISION
Wichita, Kansas

**State Corporation Commission of Kansas
Conservation Division
200 Colorado Derby Building
Wichita, Kansas 67202
(316) 263-3238**