


15-039-20002-00-00

STATE OF KANSAS
STATE CORPORATION COMMISSION

Give All Information Completely
Make Required Affidavit
Mail or Deliver Report to:
Conservation Division
State Corporation Commission
212 No. Market
Wichita, Kansas

WELL PLUGGING RECORD

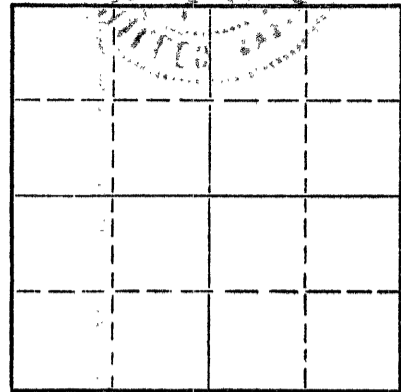

Locate well correctly on above
Section Plat

Decatur County. Sec. 33 Twp. 3 Rge. 27 (E) (W) X
Location as "NE/CNW/SW" or footage from lines C of E/2 NE NE
Lease Owner Okmar Oil Co.
Lease Name Bartos Well No. #1
Office Address 1130 Wichita Plaza
Character of Well (completed as Oil, Gas or Dry Hole)
Date well completed 19
Application for plugging filed 19
Application for plugging approved 19
Plugging commenced 9-30-67 19
Plugging completed 10-7-67 19
Reason for abandonment of well or producing formation

If a producing well is abandoned, date of last production 19
Was permission obtained from the Conservation Division or its agents before plugging was commenced?

Name of Conservation Agent who supervised plugging of this well W. L. Nichols
Producing formation Depth to top Bottom Total Depth of Well 3710' Feet
Show depth and thickness of all water, oil and gas formations.

OIL, GAS OR WATER RECORDS

CASING RECORD

FORMATION	CONTENT	FROM	TO	SIZE	PUT IN	PULLED OUT
				5 1/2"	3710'	1856.16'
				8 5/8"	231'	

Describe in detail the manner in which the well was plugged, indicating where the mud fluid was placed and the method or methods used in introducing it into the hole. If cement or other plugs were used, state the character of same and depth placed, from feet to feet for each plug set.

Made plug back with sand to 3550', mixed and ran 5 sacks cement thru dump bailer. Squeezed hole with 22 sacks gel and 5 sacks hulls, followed with 100 sacks cement. Cement from 1050' to 730', then 10 sacks gel. Gel from 730' to 240', then 20 sacks cement. Cement from 240' to 180', then 3 sacks gel. Gel from 180' to 30'. Displaced with 10 sacks cement. Cement from 30' to base of cellar.

RECEIVED
STATE CORPORATION COMMISSION

OCT 10 1967

CONSERVATION DIVISION
Wichita, Kansas

10-10-67

(If additional description is necessary, use BACK of this sheet)

Name of Plugging Contractor Southwest Casing Pulling Co., Inc.
Address Box 364, Great Bend, Kansas

STATE OF Kansas COUNTY OF Barton, ss.
Southwest Casing Pulling Co., Inc. (employee of owner) or (owner or operator) of the above-described

well, being first duly sworn on oath, says: That I have knowledge of the facts, statements, and matters herein contained and the log of the above-described well as filed and that the same are true and correct. So help me God.

(Signature) W. C. Spencer Sec.
Box 364, Great Bend, Kansas (Address)

Subscribed and sworn to before me this 9 day of October, 1967

October 1967
Sidney D. Miller
Notary Public.

