

15-039-00102-00-00

STATE OF KANSAS  
STATE CORPORATION COMMISSION

Give All Information Completely  
Make Required Affidavit  
Mail or Deliver Report to:  
Conservation Division  
State Corporation Commission  
800 Bitting Building  
Wichita, Kansas

WELL PLUGGING RECORD

Decatur

County. Sec. 33 Twp. 3S Rge. 27 (E) W (W)

Location as "NE/CNW/SW" or footage from lines SE SE NE

Lease Owner Anderson-Prichard Oil Corporation

Lease Name Brown Well No. 1

Office Address Liberty Bank Building, Oklahoma City, Oklahoma

Character of Well (completed as Oil, Gas or Dry Hole) Dry Hole

Date well completed Nov. 30, 1955

Application for plugging filed Nov. 30, 1955

Application for plugging approved Nov. 30, 1955


Plugging commenced Nov. 30, 1955

Plugging completed Nov. 30, 1955

Reason for abandonment of well or producing formation Dry Hole

If a producing well is abandoned, date of last production 19

Was permission obtained from the Conservation Division or its agents before plugging was commenced? Yes

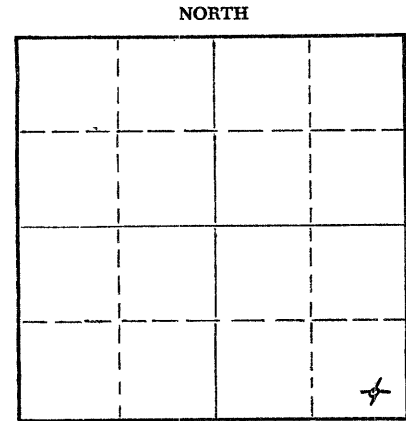

Locate well correctly on above Section Plat

Name of Conservation Agent who supervised plugging of this well Eldon Petty

Producing formation Depth to top Bottom Total Depth of Well 4074 Feet

Show depth and thickness of all water, oil and gas formations.

OIL, GAS OR WATER RECORDS

CASING RECORD

FORMATION	CONTENT	FROM	TO	SIZE	PUT IN	PULLED OUT
		0	312'	8 5/8"	312'	None

Describe in detail the manner in which the well was plugged, indicating where the mud fluid was placed and the method or methods used in introducing it into the hole. If cement or other plugs were used, state the character of same and depth placed, from feet to feet for each plug set.

From 4074' to 301 1/2' - heavy rotary mud  
 301 1/2' to 300' - wooden plug  
 300' to 254' - 15 sacks cement and 1/2 sack hulls  
 254' to 41 1/2' - heavy rotary mud  
 41 1/2' to 40' - wooden plug  
 40' to 6' - 10 sacks cement and 1/2 sack hulls  
 6' to surface- cellar

RECEIVED  
 STATE CORPORATION COMMISSION  
 DEC 6 - 1955  
 CONSERVATION DIVISION

(If additional description is necessary, use BACK of this sheet)  
 Name of Plugging Contractor Glenn W. Peel  
 Address P.O. Box 359, Hoisington, Kansas

STATE OF KANSAS, COUNTY OF BARTON, ss.  
 Glenn W. Peel (employee of owner) or (owner or operator) of the above-described well, being first duly sworn on oath, says: That I have knowledge of the facts, statements, and matters herein contained and the log of the above-described well as filed and that the same are true and correct. So help me God. GLENN W. PEEL

BY: *Glenn W. Peel*  
 P.O. Box 359, Hoisington, Kansas  
 (Address)

SUBSCRIBED AND SWORN TO before me this 2nd day of December, 1955

*Marion M. Herbert*  
 Notary Public.

My commission expires June 4, 1959

PLUGGING  
 FILE NO. 33 T 3 R 27W  
 BOOK PAGE 20 LINE 39