

15-039-20291-00-00

STATE OF KANSAS
STATE CORPORATION COMMISSION

WELL PLUGGING RECORD

Give All Information Completely
Make Required Affidavit
Mail or Deliver Report to:
Conservation Division
State Corporation Commission
P. O. Box 17027
Wichita, Kansas 67217

Decatur County, Sec. 34 Twp. 3S Rge. (E) 27 (W)

Location as "NE/CNW/SW" or footage from lines C NW NE SW
Lease Owner Raymond Oil Company, Inc.

Lease Name MACHART Well No. #1

Office Address 200 W. Douglas, Suite 800, Wichita, Ks. 67202

Character of Well (completed as Oil, Gas or Dry Hole) Dry Hole

Date well completed November 25, 1974

Application for plugging filed (verbally) November 25, 1974

Application for plugging approved (verbally) November 25, 1974


Plugging commenced November 25, 1974

Plugging completed November 25, 1974

Reason for abandonment of well or producing formation Dry Hole

If a producing well is abandoned, date of last production 19

Was permission obtained from the Conservation Division or its agents before plugging was commenced? Yes

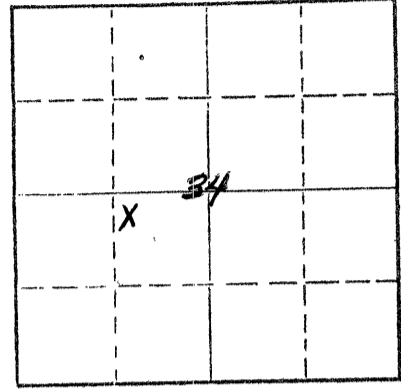

Locate well correctly on above Section Plat

Name of Conservation Agent who supervised plugging of this well Bill Nichols

Producing formation Depth to top Bottom Total Depth of Well 3600' Feet

Show depth and thickness of all water, oil and gas formations.

OIL, GAS OR WATER RECORDS

CASING RECORD

FORMATION	CONTENT	FROM	TO	SIZE	PUT IN	PULLED OUT
				8-5/8"	211.17'	None

Describe in detail the manner in which the well was plugged, indicating where the mud fluid was placed and the method or methods used in introducing it into the hole. If cement or other plugs were used, state the character of same and depth placed, from feet to feet for each plug set.

1st Plug set @ 1250' with 110 cu. ft. Cement
2nd Plug set @ 240' with 30 cu. ft. Cement
3rd Plug set @ 40' with 10 cu. ft. Cement

RECEIVED
STATE CORPORATION COMMISSION
DEC 3 1974
CONSERVATION DIVISION
Wichita, Kansas

RECEIVED
STATE CORPORATION COMMISSION
DEC 5 1974
CONSERVATION DIVISION
Wichita, Kansas


12-3-74

(If additional description is necessary, use BACK of this sheet)

Name of Plugging Contractor Abercrombie Drilling, Inc.
Address 801 Union Center, Wichita, Kansas 67202

STATE OF KANSAS, COUNTY OF SEDGWICK, ss.
Jack K. Wharton, Geologist (employee of owner) or (owner or operator) of the above-described well, being first duly sworn on oath, says: That I have knowledge of the facts, statements, and matters herein contained and the log of the above-described well as filed and that the same are true and correct. So help me God.

(Signature) Jack K. Wharton
Jack K. Wharton, 801 Union Center, Wichita, Ks.
(Address)

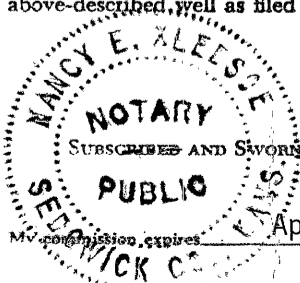

SUBSCRIBED AND SWORN to before me this 26th day of November, 1974

Nancy E. Bledsoe
Notary Public.

April 8, 1978