


15-039-20462-00-00

STATE OF KANSAS  
STATE CORPORATION COMMISSION

WELL PLUGGING RECORD

Give All Information Completely  
Make Required Affidavit  
Mail or Deliver Report to  
Conservation Division  
State Corporation Comm.  
245 North Water  
Wichita, KS 67202

Decatur County. Sec. 24 Twp. 3 Rge. 27 E/W  
Location as "NE/CNW 1/4 SW 1/4" or footage from lines \_\_\_\_\_  
2310' FWL & 2310' FSL Section 24  
Lease Owner PanCanadian Petroleum Com  
Lease Name Kincaid Well No. 1  
Office Address Helton Eng., 555 17th St., Denver 80202  
Character of Well (Completed as Oil, Gas or Dry Hole) \_\_\_\_\_  
Dry Hole

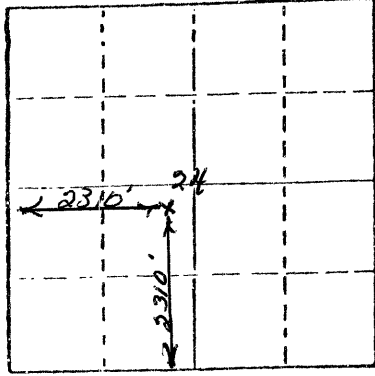

Date Well completed 9/3 1979  
Application for plugging filed verbal approval 8/31 1979  
Application for plugging approved verbal App. 8/31 1979  
Plugging commenced 4:50 PM 9/3 1979  
Plugging completed 5:30 PM 9/3 1979  
Reason for abandonment of well or producing formation \_\_\_\_\_

Dry hole  
If a producing well is abandoned, date of last production \_\_\_\_\_  
19\_\_\_\_

Was permission obtained from the Conservation Division or its agents before plugging was commenced? Yes

Name of Conservation Agent who supervised plugging of this well Gilbert Balthazor  
Producing formation NONE Depth to top \_\_\_\_\_ Bottom \_\_\_\_\_ Total Depth of Well 3775  
Show depth and thickness of all water, oil and gas formations.

OIL, GAS OR WATER RECORDS

CASING RECORD

FORMATION	CONTENT	FROM	TO	SIZE	PUT IN	PULLED OUT
	Sur. wtr.	0	180	8-5/8	223	NONE
Topeka Oread	Water	3375	3490		NONE	

Describe in detail the manner in which the well was plugged, indicating where the mud fluid was placed and the method or methods used in introducing it into the hold. If cement or other plugs were used, state the character of same and depth placed, from \_\_\_\_\_ feet to \_\_\_\_\_ feet for each plug set.

Hole was full of 9.7 lb/gal. 47 viscosity mud.

1. Spotted 70 sx 50-50 Poz containing 6% gel thru DP using Halliburton from 1150 to 900 ft.
2. Spotted 20 sx 50-50 Poz containing 6% gel thru DP using Halliburton from 220 to 160 ft.
3. Bridged hole at 40' and spotted 20 sx 50-50 Poz thru DP using Halliburton from 40' to surface.
4. Cut 8-5/8 in. 24# casing off 2' below ground level.
5. Pumped 5 sx of 50-50 Poz containing 6% gel in rathole.

(If additional description is necessary, use BACK of this sheet)

Name of Plugging Contractor Stoepelwerth Drilling, Inc. & Halliburton

STATE OF Kansas COUNTY OF Decatur

Charles O. Clark

(employee of owner) ~~XXXXXXXXXXXXXXXXXXXX~~

of the above-described well, being first duly sworn on oath, says: That I have knowledge of the facts, statements, and matters herein contained and the log of the above-described well as filed and that the same are true and correct. So help me God.

(Signature) Charles O. Clark

8600 Dawson Blvd Denver 55-17th St Denver Co 80202

(Address)

SUBSCRIBED AND SWORN TO before me this 12th day of September, 1979

Aubrie J. Smith  
Notary Public.

My commission expires My commission expires Sept. 6, 1982.

STATE RECEIVED  
CONSERVATION DIVISION  
SEP 14 1979  
WICHITA, KANSAS